

1	LOCATION OF WATER WELL:	Fraction	Section Number	Township Number	Range Number
	County: <b>GEARY</b>	<b>SW 1/4 NE 1/4 1/4</b>	<b>31</b>	<b>11 S</b>	<b>6 E</b>

Distance and direction from nearest town or city street address of well if located within city?  
**FT RILEY KS, CAMP FUNSTON FORMER BLDG 1044 WP 8(10)**

2	WATER WELL OWNER:	Board of Agriculture, Division of Water Resources
	<b>US ARMY CORPS ENGINEERS</b>	Application Number:
	RR#, St. Address, Box #:	
	<b>601 E 12TH ST</b>	
	City, State, ZIP Code :	
	<b>KC, MO 64106</b>	

3	MARK WELL'S LOCATION WITH AN "X" IN SECTION BOX:										
	N										
	<table border="1"> <tr> <td>PLS SEE</td> <td></td> </tr> <tr> <td>N W</td> <td>N E</td> </tr> <tr> <td>DWG</td> <td>E</td> </tr> <tr> <td>attached</td> <td>S E</td> </tr> <tr> <td></td> <td>S</td> </tr> </table>	PLS SEE		N W	N E	DWG	E	attached	S E		S
PLS SEE											
N W	N E										
DWG	E										
attached	S E										
	S										

4	DEPTH OF WELL: <b>23.9</b> .....ft.												
	WELL'S STATIC WATER LEVEL: <b>200</b> .....ft.												
	WELL WAS USED AS:												
	<table border="0"> <tr> <td>1 Domestic</td> <td>5 Public Water Supply</td> <td>9 Dewatering</td> </tr> <tr> <td>2 Irrigation</td> <td>6 Oil Field Water Supply</td> <td>10 Monitoring Well</td> </tr> <tr> <td>3 Feedlot</td> <td>7 Lawn and Garden Only</td> <td>11 Injection Well</td> </tr> <tr> <td>4 Industrial</td> <td>8 Air Conditioning</td> <td>12 Other.....</td> </tr> </table>	1 Domestic	5 Public Water Supply	9 Dewatering	2 Irrigation	6 Oil Field Water Supply	10 Monitoring Well	3 Feedlot	7 Lawn and Garden Only	11 Injection Well	4 Industrial	8 Air Conditioning	12 Other.....
1 Domestic	5 Public Water Supply	9 Dewatering											
2 Irrigation	6 Oil Field Water Supply	10 Monitoring Well											
3 Feedlot	7 Lawn and Garden Only	11 Injection Well											
4 Industrial	8 Air Conditioning	12 Other.....											
	<p>Was a chemical/bacteriological sample submitted to Department? Yes.....No. <b>X</b></p> <p>If yes, mo/day/yr sample was submitted.....</p> <p>Water Well Disinfected: Yes..... No. <b>X</b></p>												

5	TYPE OF BLANK CASING USED:										
	<table border="0"> <tr> <td>1 Steel</td> <td>3 RMP (SR)</td> <td>5 Wrought</td> <td>7 Fiberglass</td> <td>9 Other (specify below)</td> </tr> <tr> <td>2 PVC</td> <td>4 ABS</td> <td>6 Asbestos-Cement</td> <td>8 Concrete Tile</td> <td></td> </tr> </table>	1 Steel	3 RMP (SR)	5 Wrought	7 Fiberglass	9 Other (specify below)	2 PVC	4 ABS	6 Asbestos-Cement	8 Concrete Tile	
1 Steel	3 RMP (SR)	5 Wrought	7 Fiberglass	9 Other (specify below)							
2 PVC	4 ABS	6 Asbestos-Cement	8 Concrete Tile								
	Blank casing diameter..... <b>1</b> .....in. Was casing pulled? Yes <b>X</b> No..... If yes, how much <b>40'</b> .....										
	Casing height above or below land surface: <b>FLUSH M.D.</b> in.										


6	GROUT PLUG MATERIAL: 1 Neat cement 2 Cement grout <b>3 Bentonite</b> 4 Other.....																				
	Grout Plug Intervals: From.....ft. to <b>23.9</b> ft., From.....ft. to <b>3.5</b> ft., From.....ft. to .....ft., From..... to .....ft.																				
	What is the nearest source of possible contamination:																				
	<table border="0"> <tr> <td>1 Septic tank</td> <td>6 Seepage pit</td> <td>11 Fuel storage</td> <td>16 Other (specify below)</td> </tr> <tr> <td>2 Sewer lines</td> <td>7 Pit privy</td> <td>12 Fertilizer storage</td> <td></td> </tr> <tr> <td>3 Watertight sewer lines</td> <td>8 Sewage lagoon</td> <td>13 Insecticide storage</td> <td></td> </tr> <tr> <td>4 Lateral lines</td> <td>9 Feedyard</td> <td>14 Abandoned water well</td> <td><b>FORMER UST SITE</b></td> </tr> <tr> <td>5 Cess Pool</td> <td>10 Livestock pens</td> <td>15 Oil well/Gas well</td> <td></td> </tr> </table>	1 Septic tank	6 Seepage pit	11 Fuel storage	16 Other (specify below)	2 Sewer lines	7 Pit privy	12 Fertilizer storage		3 Watertight sewer lines	8 Sewage lagoon	13 Insecticide storage		4 Lateral lines	9 Feedyard	14 Abandoned water well	<b>FORMER UST SITE</b>	5 Cess Pool	10 Livestock pens	15 Oil well/Gas well	
1 Septic tank	6 Seepage pit	11 Fuel storage	16 Other (specify below)																		
2 Sewer lines	7 Pit privy	12 Fertilizer storage																			
3 Watertight sewer lines	8 Sewage lagoon	13 Insecticide storage																			
4 Lateral lines	9 Feedyard	14 Abandoned water well	<b>FORMER UST SITE</b>																		
5 Cess Pool	10 Livestock pens	15 Oil well/Gas well																			
	Direction from well? ..... How many feet? .....																				

FROM	TO	PLUGGING MATERIALS
<b>23.9</b>	<b>3.0</b>	<b>Bentonite</b>
<b>3.0</b>	<b>0</b>	<b>Clay the Native Soil</b>

**Geoprobe Grout machine w tremi**

7	CONTRACTOR'S OR LANDOWNER'S CERTIFICATION: This water well was plugged under my jurisdiction and was completed on (mo/day/year)..... and this record is true to the best of my knowledge and belief. Kansas Water Well Contractor's License No. .... This Water Well Record was completed on (mo/day/year) ..... under the business name of ..... by (signature) .....
---	--

INSTRUCTIONS: Use typewriter or ball point pen. Please press firmly and print clearly. Please fill in blanks, underline or circle the correct answers. Send top three copies to Kansas Department of Health and Environment, Bureau of Water, Topeka, Kansas 66620-0001. Telephone: 913/296-3565. Send one to Water Well Owner and retain one for your records.

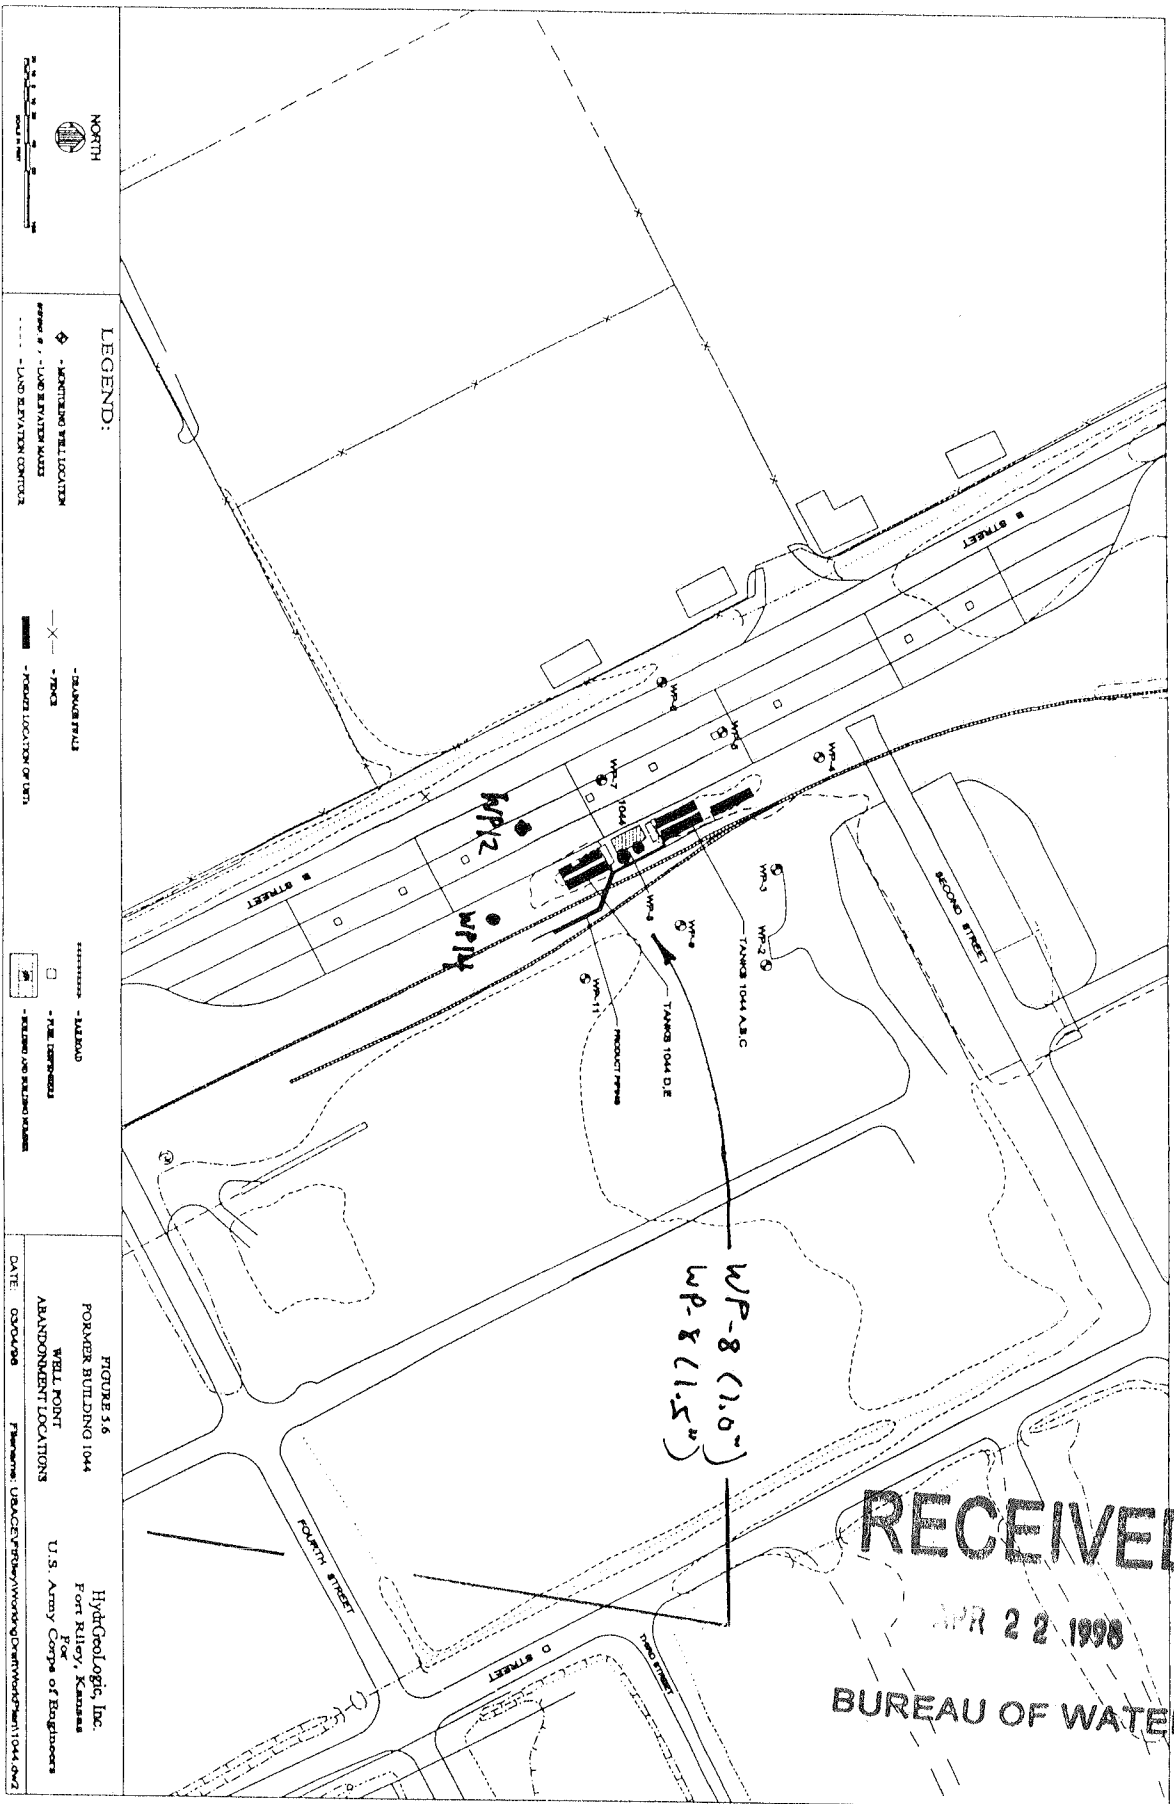

PIEZOMETRIC WP 8 (1.0")  
FORMER BLDG 1044

WP-8 (1.0")  
WP-8 (1.5")

RECEIVED  
APR 22 1998  
BUREAU OF WATER

FIGURE 3.6  
FORMER BUILDING 1044  
WELL POINT  
ABANDONMENT LOCATIONS  
DATE: 03/04/98  
HydroGeologic, Inc.  
Fort Riley, Kansas  
U.S. Army Corps of Engineers  
Project: USACE/FR/RY/WORKING DRAFT WORK PLAN 1044.DWG