
one for your records.

			T						
1 LOCATION OF WATER WELL:			Fraction		Section Number	Townsh	ip Number	Ran	ge Number
County: 🤇	NAES	1	SC01/4/201/4	1/4	3/	1 /	2	6	6
Distance and direction from nearest town or city street address of well if located within city?									
FORT RUEY, KS. CAMP FUNSTON FORMER BLDG 1637 WP-9									
2 WATER WELL OWNER: US ARMY CORPS OF ENGINEERS  BR# St Address Roy #: 60/E, 127H ST.  Board of Agriculture Division of Water Resources									
RR#, St. Address, Box #:  City, State, ZIP Code: KC MO, 64106  Board of Agriculture, Division of Water Resources  Application Number:									
AN "X"  PLS	SEE  N SEE  N SCHED	TION WITH I BOX:	4 DEPTH OF WE WELL'S STAT WELL WAS US 1 Domest 2 Irriga 3 Feedlo 4 Indust	IC WATE ED AS: ic tion et rial	F Public Water S 6 Oil Field Water 7 Lawn and Garde 8 Air Conditions	Supply or Supply on Only ng	9 Dewaterir 10 Monitorir 11 Injection 12 Other PIEZOW to Departmer	ng Well Well	C Z
If yes, mo/day/yr sample was submitted									
Water Well Disinfected: Yes No X									
5 TYPE OF BLANK CASING USED:									
1 Steel 3 RMP (SR) 5 Wrought 7 Fiberglass 9 Other (specify below) 2 PVC 4 ABS 6 Asbestos-Cement 8 Concrete Tile  Blank casing diameterin. Was casing pulled? Yes. No If yes, how much Casing height above or below land surface. I. U.S. No									
6 GROUT PLUG MATERIAL: 1 Neat cement 2 Cement grout 3 Bentonite 4 Other									
Grout Plug Intervals: Fromft. toft., Fromft. toft., From									
What is the nearest source of possible contamination:									
1 Septic tank 6: 2 Sewer lines 7: 3 Watertight sewer lines 8: 4 Lateral lines 9:			6 Seepage pit 7 Pit privy	1	11 Fuel storage 12 Fertilizer sto 13 Insecticide st 14 Abandoned wate 15 Oil well/Gas u	orage corage er well	16 Other (sp FORMS		
Direction from well? How many feet?									
FROM	то	PL	UGGING MATERIALS						
24	5	Bakro	LITTE SLUAN		GEOG	MOBE	GROUT	- P <	, mp
5	0		+ NATIVE	JS07	L + TRE	m, us	<b>30</b>		
7 CONTRACTOR'S OR LANDOWNER'S CERTIFICATION: This water well was plugged under my jurisdiction and was completed on (mo/day/year). 4 9 9 and this record is true to the best of my knowledge and belief. Kansas Water Well Contractor's License No. 6 This Water Well Record was completed on (mo/day/year). 4 9 under the business name of 6 9 10									
INSTRUCTIONS: Use typewriter or ball point pen. <u>Please press firmly</u> and <u>print</u> clearly. Please fill in blanks, underline or circle the correct answers. Send top three copies to Kansas Department of Health and Environment, Bureau of Water, Topeka, Kansas 66620-0001. Telephone: 913/296-3565. Send one to Water Well Owner and retain									

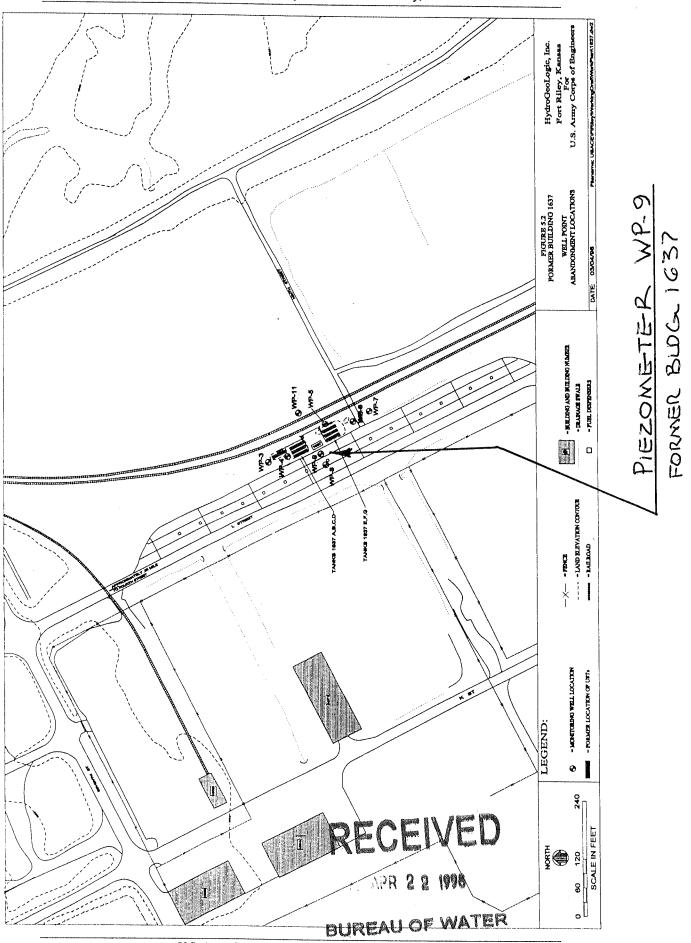

U.S. Army Corps of Engineers—Kansas City District