
		R WELL RECORD	Form WWC-5	KSA 82	a-1212		
1 LOCATION OF WATER WELL	Fraction	D		tion Number		nber	Range Number
County: GEARY	SW 1/4		1/4	<u> </u>		s l	R 6 (E)W
Distance and direction from near					a present some	100	<u>~~</u>
FORT KILEY,	KS CAMP	FUNSTON F	<u>ormer</u>	BUDG	1656	WP-	2
2 WATER WELL OWNER:	US ARMY C	lorps of e	NGNB	EN S			
RR#, St. Address, Box # :	601 E. 12	THST			Board of Ag	riculture, D	ivision of Water Resources
City, State, ZIP Code :	KC, MC	6410G	·		Application		# 1744 MM (1745)
LOCATE WELL'S LOCATION	WITH 4 DEPTH OF C	COMPLETED WELL	24.0	ft. ELEVA	ATION: 107.	3,12	
AN "X" IN SECTION BOX:							
							3-4-95
PLS SEE!	Pum						nping gpm
am am NW am am am NE am	estero II	•				•	nping gpm
AMACHED							toft.
W processor and the second sec	onace -	TO BE USED AS:	5 Public wate		8 Air conditioning		njection well
i PwG.	1 Domestic				9 Dewatering		Other (Specify below)
SW was see SE w	2 Irrigation	4 Industrial	7 Lawn and c	iarden only	10 Monitoring well	PIEZ	ometer
							mo/day/yr sample was sub-
And the second s	mitted	bacteriological sample	Submitted to Di		ater Well Disinfected		No X
5 TYPE OF BLANK CASING US		C Menualit ivan	8 Concre				Clamped
musa.		5 Wrought iron					ed
C STANDONE STANDON STA	MP (SR)	6 Asbestos-Cement		(specify belo	·		ded. FLUSH
2 PVC 4 AI		7 Fiberglass					
Blank casing diameter							
Casing height above land surface		in., weight					
TYPE OF SCREEN OR PERFOR			₹ 7 PV			stos-ceme	
1 Steel 3 St	ainless steel	5 Fiberglass		IP (SR)			
	alvanized steel	6 Concrete tile	9 AB	S	12 None	used (ope	, and the second
SCREEN OR PERFORATION O			zed wrapped		8 Saw cut		11 None (open hole)
1 Continuous slot	3 Mill slot		wrapped		9 Drilled holes		
2 Louvered shutter	4 Key punched	7 Torcl	h cut		10 Other (specify)		
SCREEN-PERFORATED INTER	/ALS: From	🏌 ft. to .	<	ft., Fro	om	ft. to	
	From	ft. to .		ft., Fro	om	ft. to	D
GRAVEL PACK INTER	VALS: From	ft. to .		ft., Fro	om		o
	r	ts so		AL P.		ft. to	
	From	ft. to	c separation and a sepa	ft., Fro	om		
	Neat cement	2 Cement grout	3 Bento	nite ) 4	Other		
Grout Intervals: From What is the nearest source of po	Neat cement	2 Cement grout		to10 Live	Other	14 At	. ft. to
Grout Intervals: From  What is the nearest source of po	Neat cementft. to	2 Cement grout ft., From	· · · · · · · · · · · · · · · · · · ·	to	Other	14 At 15 Oi	ft. toft. candoned water well il well/Gas well ther (specify below)
Grout Intervals: From What is the nearest source of po	Neat cementft. to ssible contamination: Lateral lines Cess pool	2 Cement grout ft., From 7 Pit privy	· · · · · · · · · · · · · · · · · · ·	10 Live 11 Fuel 12 Ferti	Other from stock pens	14 At 15 Oi	ft. toft. pandoned water well
Grout Intervals: From  What is the nearest source of portion of the source	Neat cementft. to ssible contamination: Lateral lines Cess pool	2 Cement grout ft., From 7 Pit privy 8 Sewage lag	· · · · · · · · · · · · · · · · · · ·	10 Live 11 Fuel 12 Ferti 13 Inse	Other	14 At 15 Oi 16 Oi FORM SITE	on ft. to
Grout Intervals: From  What is the nearest source of portion of the source of	Neat cementft. to ssible contamination: Lateral lines Cess pool	2 Cement grout ft., From 7 Pit privy 8 Sewage lac 9 Feedyard	· · · · · · · · · · · · · · · · · · ·	10 Live 11 Fuel 12 Ferti 13 Inse	Other	14 At 15 Oi 16 Oi FORM SITE	on ft. to
Grout Intervals: From	Neat cementft. to ssible contamination: Lateral lines Cess pool Seepage pit LITHOLOGIC COTTING	2 Cement grout ft., From 7 Pit privy 8 Sewage lac 9 Feedyard C LOG S A / NS / Pot	goon FROM (CV) was (1) constru	10 Live 11 Fuel 12 Fert 13 Inse How ma TO	constructed, or (3) p	14 At 15 Oi 16 Or	er my jurisdiction and was
Grout Intervals: From  What is the nearest source of points of the source	Neat cementft. to ssible contamination: Lateral lines Cess pool Seepage pit LITHOLOGIC COTTINO  OWNER'S CERTIFICA No. 60	2 Cement grout ft.



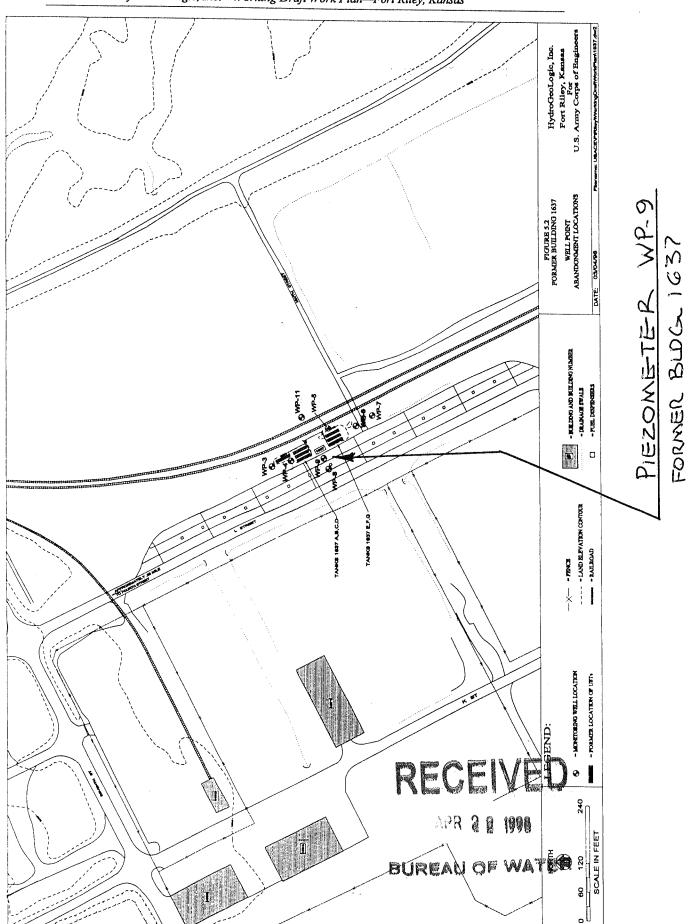

U.S. Army Corps of Engineers—Kansas City District