

1	LOCATION OF WATER WELL:	Fraction	Section Number	Township Number	Range Number
County:	GERRY	SW 1/4 N1/4 1/4	31	11 S	6 E

Distance and direction from nearest town or city street address of well if located within city?  
 Ft Riley, KS CAMP FORTN FORMER BLDG 1094 WP-11

2 WATER WELL OWNER: US ARMY CORPS OF ENGINEERS  
 RR#, St. Address, Box #: 601 E 12TH ST.  
 City, State, ZIP Code : KC, MO 64106  
 Board of Agriculture, Division of Water Resources  
 Application Number: 240

3 MARK WELL'S LOCATION WITH AN "X" IN SECTION BOX:

N			
W	PHASE		E
	See		
	Attached		
	DWG		
S			

4 DEPTH OF WELL..... 240 .....ft.  
 WELL'S STATIC WATER LEVEL.....ft.  
 WELL WAS USED AS:  
 1 Domestic      5 Public Water Supply      9 Dewatering  
 2 Irrigation    6 Oil Field Water Supply    10 Monitoring Well  
 3 Feedlot       7 Lawn and Garden Only    11 Injection Well  
 4 Industrial    8 Air Conditioning        12 Other.....  
 PIEZOMETER

Was a chemical/bacteriological sample submitted to Department? Yes.....No.....  
 If yes, mo/day/yr sample was submitted.....  
 Water Well Disinfected: Yes..... No.....

5 TYPE OF BLANK CASING USED:

1 Steel	3 RMP (SR)	5 Wrought	7 Fiberglass	9 Other (specify below)
2 PVC	4 ABS	6 Asbestos-Cement	8 Concrete Tile	

Blank casing diameter..... 1 .....in.      Was casing pulled? Yes..... No..... If yes, how much..... 3.5 .....  
 Casing height above or below land surface..... FLUSH..... in.

6 GROUT PLUG MATERIAL: 1 Neat cement    2 Cement grout    3 Bentonite    4 Other.....

Grout Plug Intervals: From..... 24 .....ft. to..... 3 .....ft., From.....ft. to .....ft., From..... to .....ft.

What is the nearest source of possible contamination:

1 Septic tank	6 Seepage pit	11 Fuel storage	16 Other (specify below)
2 Sewer lines	7 Pit privy	12 Fertilizer storage	
3 Watertight sewer lines	8 Sewage lagoon	13 Insecticide storage	FORMER UST
4 Lateral lines	9 Feedyard	14 Abandoned water well	SITE
5 Cess Pool	10 Livestock pens	15 Oil well/Gas well	


Direction from well? .....      How many feet? .....

FROM	TO	PLUGGING MATERIALS
24	30	Bentonite
30	0	Clay then native soil

Geoprobe grout unit w tremi line used

7 CONTRACTOR'S OR LANDOWNER'S CERTIFICATION: This water well was plugged under my jurisdiction and was completed on (mo/day/year)..... 4-10-98 ..... and this record is true to the best of my knowledge and belief. Kansas Water Well Contractor's License No. .... 606 ..... This Water Well Record was completed on (mo/day/year) ..... 4-18-98 ..... under the business name of ..... E.S.C.C. .... d.p.a. PSA ENV ..... by (signature) .....

INSTRUCTIONS: Use typewriter or ball point pen. Please press firmly and print clearly. Please fill in blanks, underline or circle the correct answers. Send top three copies to Kansas Department of Health and Environment, Bureau of Water, Topeka, Kansas 66620-0001. Telephone: 913/296-3565. Send one to Water Well Owner and retain one for your records.

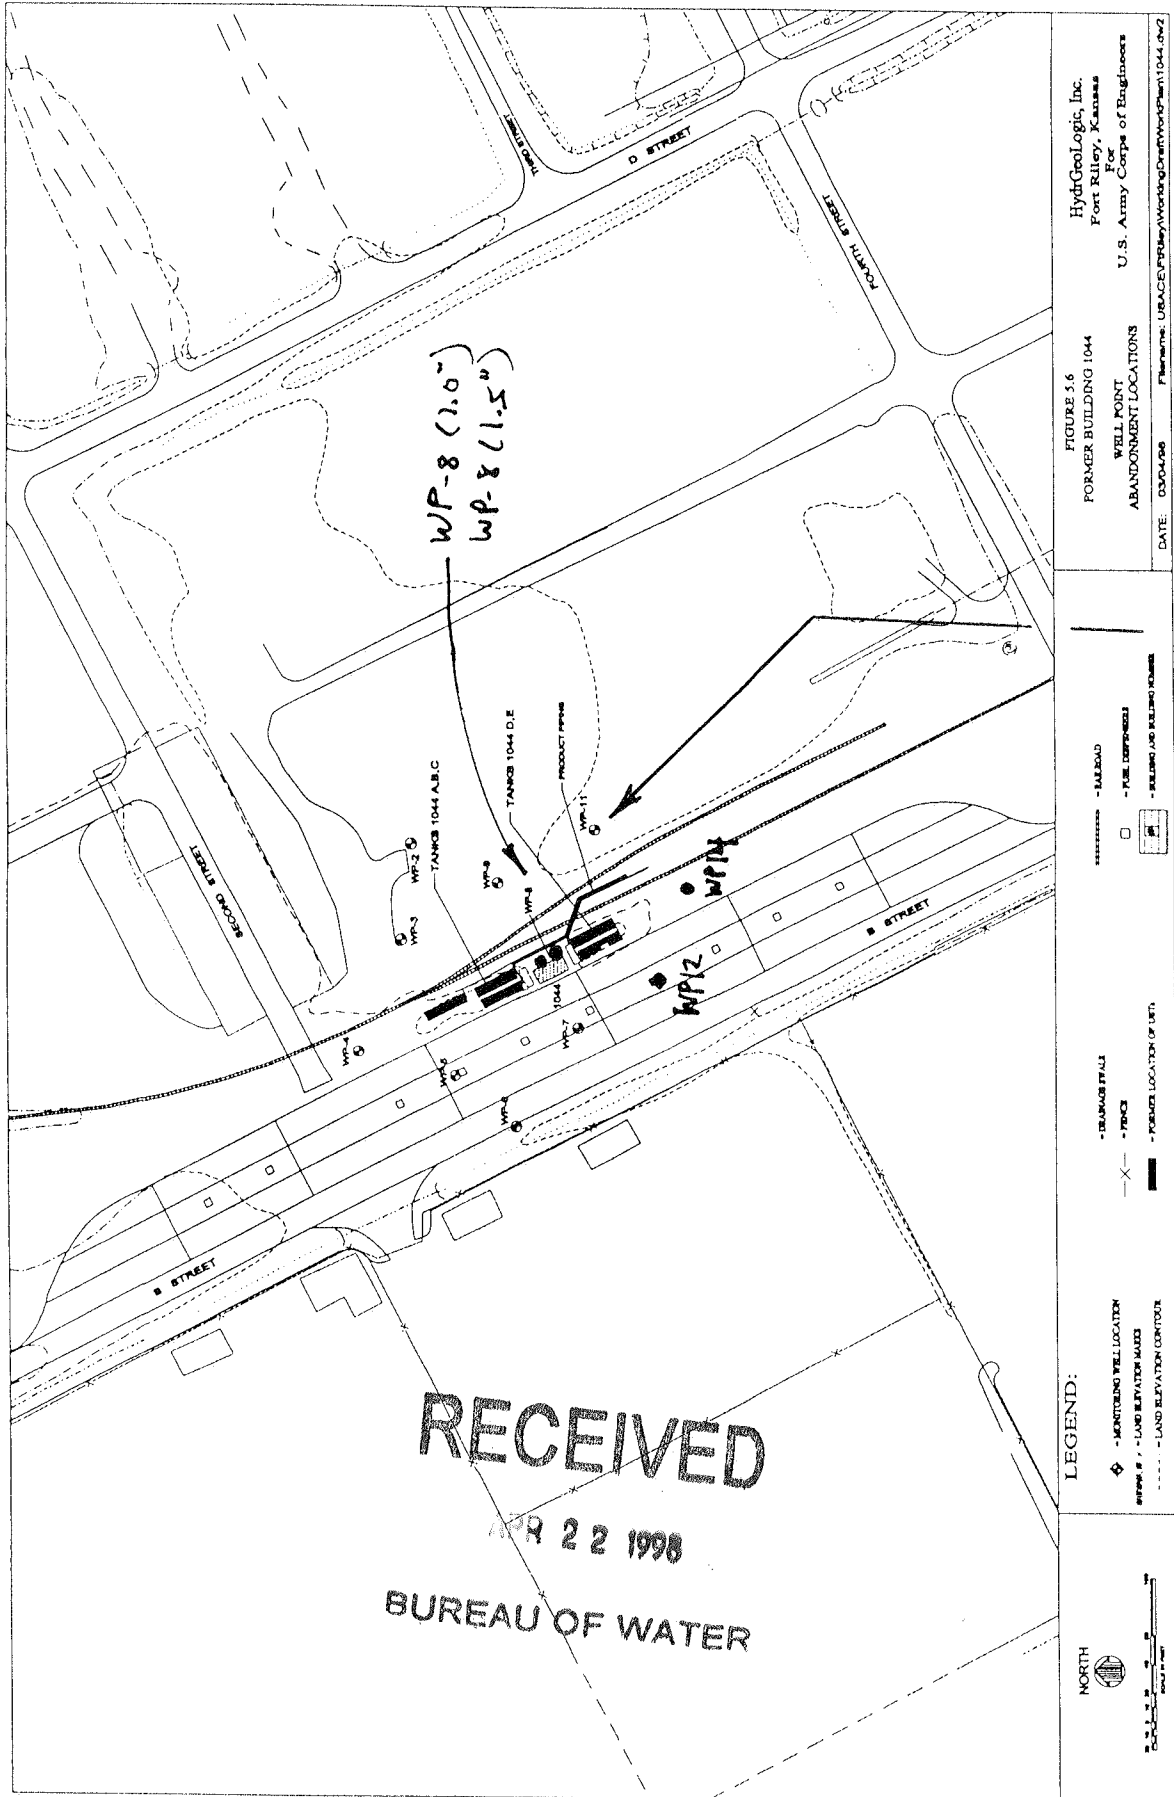

PIEZOMETER WP-11  
FORMER BLDG 1044