
.2	WATER WELL	RECORD Fo	rm WWC-5	KSA 82		A.,	Secretarian de la constitución d
I LOCATION OF WATER WELL:	Fraction		144000	ion Number	Township 1	Number	Range Number
County: GENILY	1500 1/4 1003		1/4 5		<u> </u>	S	R () (E)W
Distance and direction from nearest town					8 A A	, day	
	19MP FULSTS	N FORM	<u>131 US1</u>	LOG		WP-	
2 WATER WELL OWNER: 45 A	KMY CORP	'S OF G	sh ch	ieen's	>		
RR#, St. Address, Box # : CO/	E IZUST	.ai			Board of	Agriculture, L	Division of Water Resources
City, State, ZIP Code : CC.	, MO 64	106	The logical and a second		Application	n Number:	
3 LOCATE WELL'S LOCATION WITH 4	DEPTH OF COMPLET	ED WELL	4.	. ft. FI FV			
AN "X" IN SECTION BOX:	anth(s) Groundwater En	countered 1	221	ft	2	ff Q	tt.
CO C	ELL'S STATIC WATER	LEVEL 2.1	Z 4 h	dow land or	rface measured a	n moldaylve	3-5-98
PLS SEE W							·
000 400 NW 400 400 000 NF 400 400						•	mping gpm
							mping gpm
W programment f							to
E DUSCE W	ELL WATER TO BE US		Public water		8 Air conditionin	, although a part	Injection well
SW - SE -	1 Domestic 3		Oil field water				Other (Specify below)
	•						OMETER
	'as a chemical/bacteriolo	gical sample sub	mitted to De	partment? \	′esNo}	(); If yes,	mo/day/yr sample was sub-
AND DESCRIPTION OF THE PROPERTY OF THE PROPERT	itted			•	ater Well Disinfect	•	No X
5 TYPE OF BLANK CASING USED:	5 Wrou	ight iron	8 Concre	te tile	CASING JO	DINTS: Glued	d Clamped
1 Steel 3 RMP (SR)		stos-Cement		specify belo	·W)	Welde	ed
2 PVC) 4 ABS	7 Fiber		,		····		aded. FUSH
Blank casing diameter in.	- 1 /	•					
Casing height above land surface.							
		grit					
TYPE OF SCREEN OR PERFORATION N			7 PVC	Mary State		sbestos-ceme	
1 Steel 3 Stainless st				P (SR)			
2 Brass 4 Galvanized		crete tile	9 ABS	>		one used (op	,
SCREEN OR PERFORATION OPENINGS	S ARE:	5 Gauzed			8 Saw cut		11 None (open hole)
	slot 0.010	6 Wire wra	apped		9 Drilled holes	3	
2 Louvered shutter 4 Key	punched	7 Torch cy	^		, ,		
SCREEN-PERFORATED INTERVALS:	From S. T	ft. to <i>c</i>	み/	ft., Fro	om , , , , ,	ft. te	o
						ft. t	o
GRAVEL PACK INTERVALS:	From	ft. to		ft., Fro	om		oft. oft.
	From	ft. to		ft., Fro	om	ft. to	o
	From. From. From	ft. to ft. to ft. to ft. to	A Commission of the Commission	ft., Fro	om	ft. t	o
GRAVEL PACK INTERVALS: 6 GROUT MATERIAL: 1 Neat cer Grout Intervals: From	From From 2 Ceme to ft., ontamination: lines cool ge pit 1 STATION CONTROL CON	s water well was	3 Benton ft. 1 FROM (1) construct Record wa	tt., From tt., F	om	ft. to ft	der my jurisdiction and was lowledge and belief. Kansas

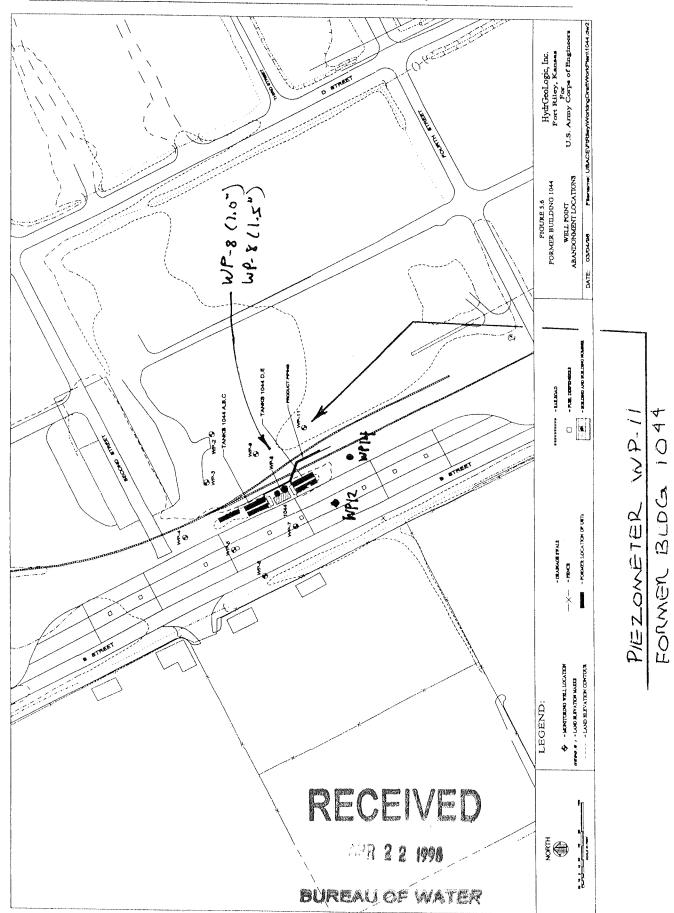

U.S. Army Corps of Engineers—Kansas City District