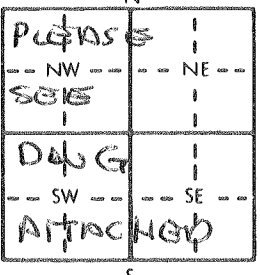


1 LOCATION OF WATER WELL: Fraction SW 1/4 NE 1/4 Section Number 31 Township Number T 11 S Range Number R 6 E/W  
 County GEARY

Distance and direction from nearest town or city street address of well if located within city?  
FORT RILEY, KS. CAMP FUNKION FORMER BLDG 1637 WP-811

2 WATER WELL OWNER: U.S. ARMY CORPS OF ENGINEERS  
 RR#, St. Address, Box #: 601 E 12TH ST Board of Agriculture, Division of Water Resources  
 City, State, ZIP Code: KC, MO. 64106 Application Number:

3 LOCATE WELL'S LOCATION WITH AN "X" IN SECTION BOX:  


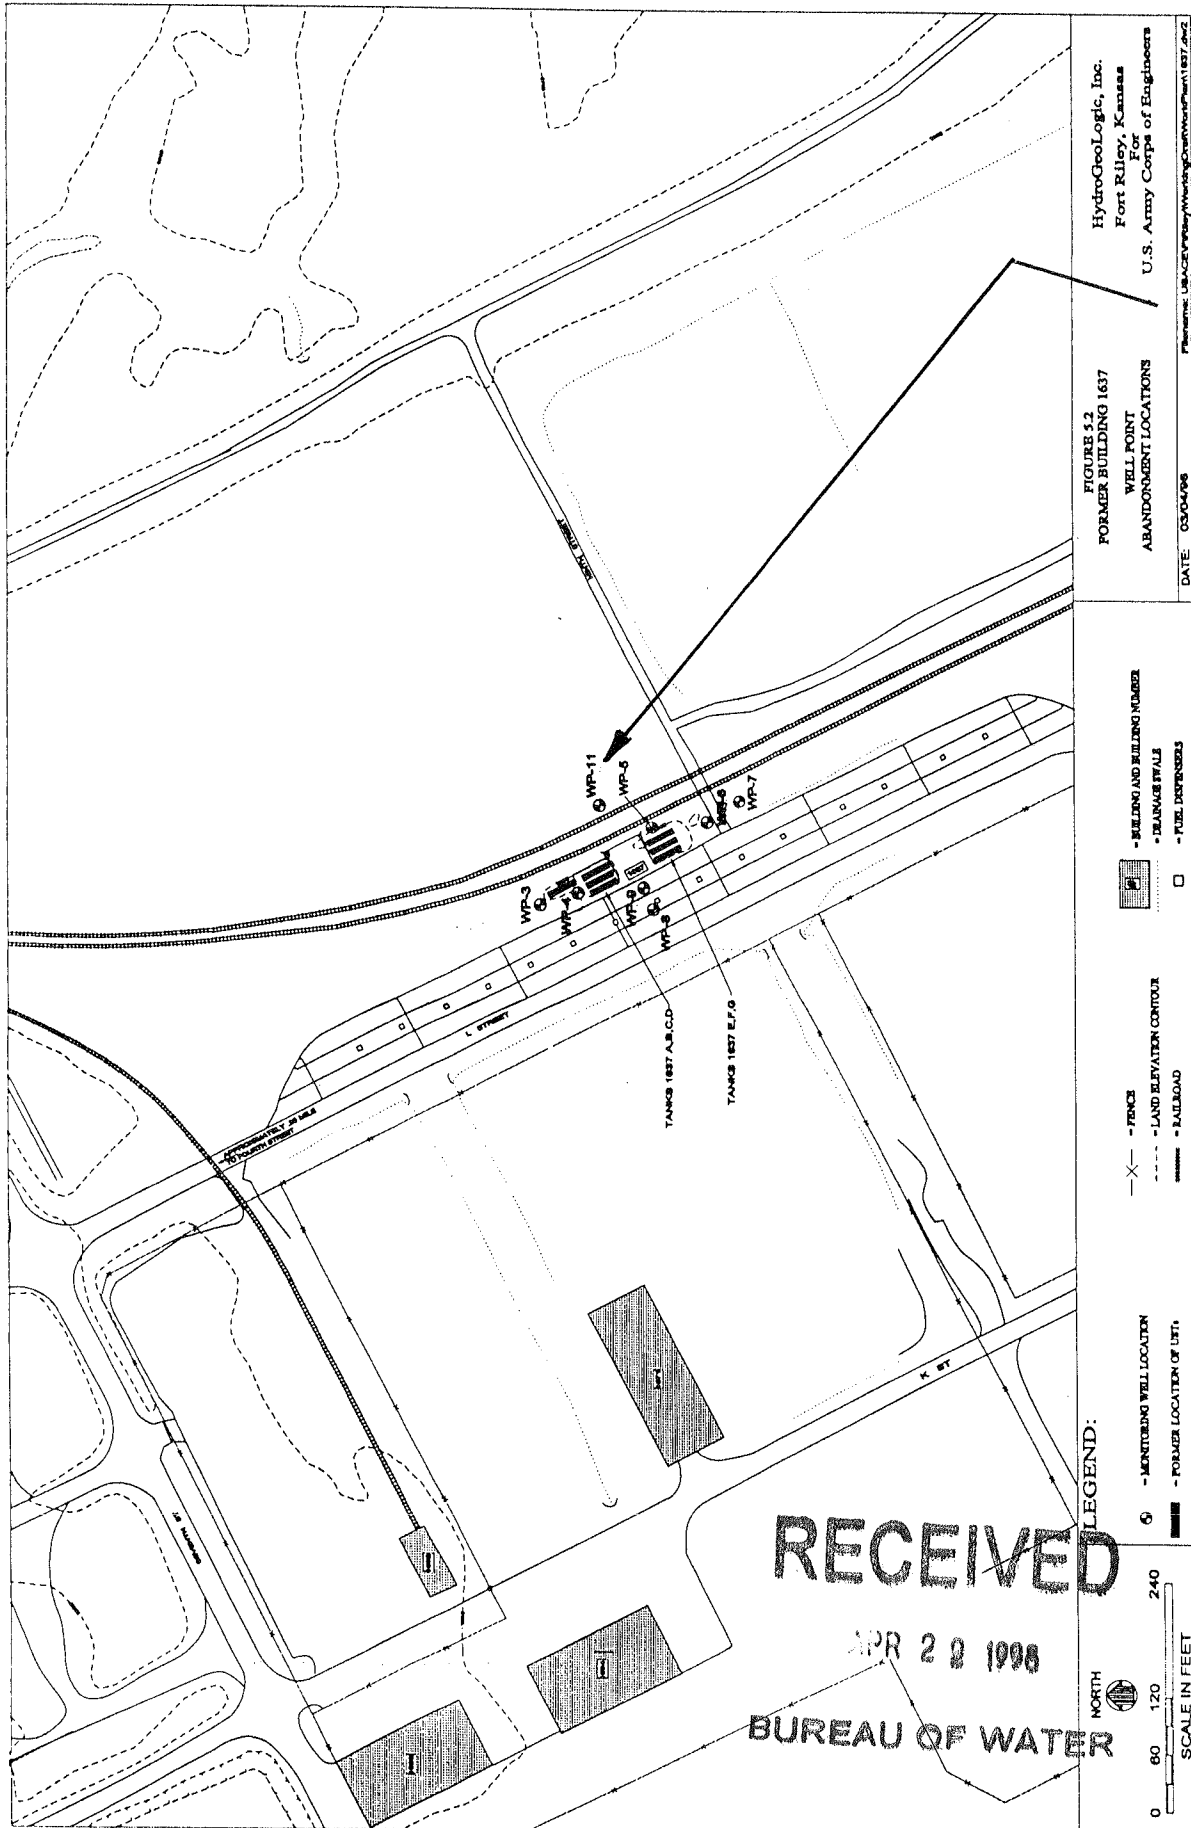
4 DEPTH OF COMPLETED WELL: 24.2 ft. ELEVATION: 1074.87  
 Depth(s) Groundwater Encountered 124.0 ft. 2. .... ft. 3. .... ft.  
 WELL'S STATIC WATER LEVEL 23.1 ft. below land surface measured on mo/day/yr 3-1-95  
 Pump test data: Well water was ..... ft. after ..... hours pumping ..... gpm  
 Est. Yield ..... gpm: Well water was ..... ft. after ..... hours pumping ..... gpm  
 Bore Hole Diameter: 1 in. to ..... ft., and ..... in. to ..... ft.  
 WELL WATER TO BE USED AS: 5 Public water supply 8 Air conditioning 11 Injection well  
 1 Domestic 3 Feedlot 6 Oil field water supply 9 Dewatering 12 Other (Specify below)  
 2 Irrigation 4 Industrial 7 Lawn and garden only 10 Monitoring well .. PIEZOMETER  
 Was a chemical/bacteriological sample submitted to Department? Yes.....No X.....; If yes, mo/day/yr sample was sub-  
 mitted Water Well Disinfected? Yes No X

5 TYPE OF CASING USED: 1 Steel 3 RMP (SR) 5 Wrought iron 8 Concrete tile CASING JOINTS: Glued ..... Clamped .....  
2 PVC 4 ABS 6 Asbestos-Cement 9 Other (specify below) Welded .....  
 7 Fiberglass Threaded FLUSH  
 Blank casing diameter ..... in. to 23.2 ft., Dia ..... in. to ..... ft., Dia ..... in. to ..... ft.  
 Casing height above land surface FLUSH M.T.O. in., weight ..... lbs./ft. Wall thickness or gauge No. SCH 40  
 TYPE OF SCREEN OR PERFORATION MATERIAL: 7 PVC 10 Asbestos-cement  
 1 Steel 3 Stainless steel 5 Fiberglass 8 RMP (SR) 11 Other (specify) .....  
 2 Brass 4 Galvanized steel 6 Concrete tile 9 ABS 12 None used (open hole)  
 SCREEN OR PERFORATION OPENINGS ARE: 5 Gauzed wrapped 8 Saw cut 11 None (open hole)  
 1 Continuous slot 3 Mill slot 0.010 6 Wire wrapped 9 Drilled holes  
 2 Louvered shutter 4 Key punched 7 Torch cut 10 Other (specify) .....  
 SCREEN-PERFORATED INTERVALS: From 24.2 ft. to 21.2 ft., From ..... ft. to ..... ft.  
 GRAVEL PACK INTERVALS: From ..... ft. to ..... ft., From ..... ft. to ..... ft.

6 GROUT MATERIAL: 1 Neat cement 2 Cement grout 3 Bentonite 4 Other .....  
 Grout Intervals: From 0 ft. to 4' ft., From ..... ft. to ..... ft., From ..... ft. to ..... ft.  
 What is the nearest source of possible contamination:  
 1 Septic tank 4 Lateral lines 7 Pit privy 10 Livestock pens 14 Abandoned water well  
 2 Sewer lines 5 Cess pool 8 Sewage lagoon 11 Fuel storage 15 Oil well/Gas well  
 3 Watertight sewer lines 6 Seepage pit 9 Feedyard 12 Fertilizer storage 16 Other (specify below)  
FORMER U.S. SITE  
 Direction from well? How many feet?

FROM	TO	LITHOLOGIC LOG	FROM	TO	PLUGGING INTERVALS
0	24.2	DIRECT PUSA INSTALLED WITHOUT CUTTINGS			

7 CONTRACTOR'S OR LANDOWNER'S CERTIFICATION: This water well was (1) constructed, (2) reconstructed, or (3) plugged under my jurisdiction and was completed on (mo/day/year) 3-1-95 and this record is true to the best of my knowledge and belief. Kansas Water Well Contractor's License No. 6006 This Water Well Record was completed on (mo/day/yr) 4-15-98 under the business name of ESCC dba PSA ENV. by (signature) [Signature]



PIEZOMETER WP-11  
FORMER BLDG 1637