
1 LOCATION OF HATER VIEW	Frankin	Continu Number	Tourship Number	Panga Mumbas
1 LOCATION OF WATER WELL:	Fraction	Section Number	Township Number	Range Number
County: (SERV) Distance and direction from ne	SW 1/4 NB1/4 1/4	A		6 3
PHRILEY KS	CAMP FUN' ARMY CORPS & O/ E/ZTH ST C. MO 64/C	Board of Agricon No.	SULTURE, Division of Lumber:	
PLS SEE N W SEE N W SEE S W S E	WELL WAS USED AS: 1 Domestic 2 Irrigation 3 Feedlot 4 Industrial Was a chemical/bact	5 Public Water Supp 6 Oil Field Water S 7 Lawn and Garden G 8 Air Conditioning eriological sample st ample was submitted.	oly 9 Dewaterin Supply 10 Monitorin	g Well Well
5 TYPE OF BLANK CASING USED:				
		ete Tile	(specify below) No If yes, how	much
6 GROUT PLUG MATERIAL: 1 Ne Grout Plug Intervals: F	at cement 2 Cement gro	The state of the s	4 Other	
What is the nearest source 1 Septic tank 2 Sewer lines 3 Watertight sewer lines 4 Lateral lines 5 Cess Pool	6 Seepage pit 7 Pit privy	n: 11 Fuel storage 12 Fertilizer stora 13 Insecticide stor 14 Abandoned water 15 Oil well/Gas wel	ge Fonnen well	pecify below)
Direction from well?		How many feet?		
FROM TO 3 Rev	PLUGGING MATERIALS TOUTH Y Than Wating	Soil DA	eniths	at syste
7 CONTRACTOR'S OR LANDOWNER' on (mo/day/year)	and this recoicense No	ord is true to the be This Water Well	est of my knowledge am Record was completed	nd belief. Kansas d on (mo/day/year)
INSTRUCTIONS: Use typewriter underline or circle the correbureau of Water, Topeka, Kansone for your records.	ect answers. Send top the	ree copies to Kansas	Department of Health	and Environment,

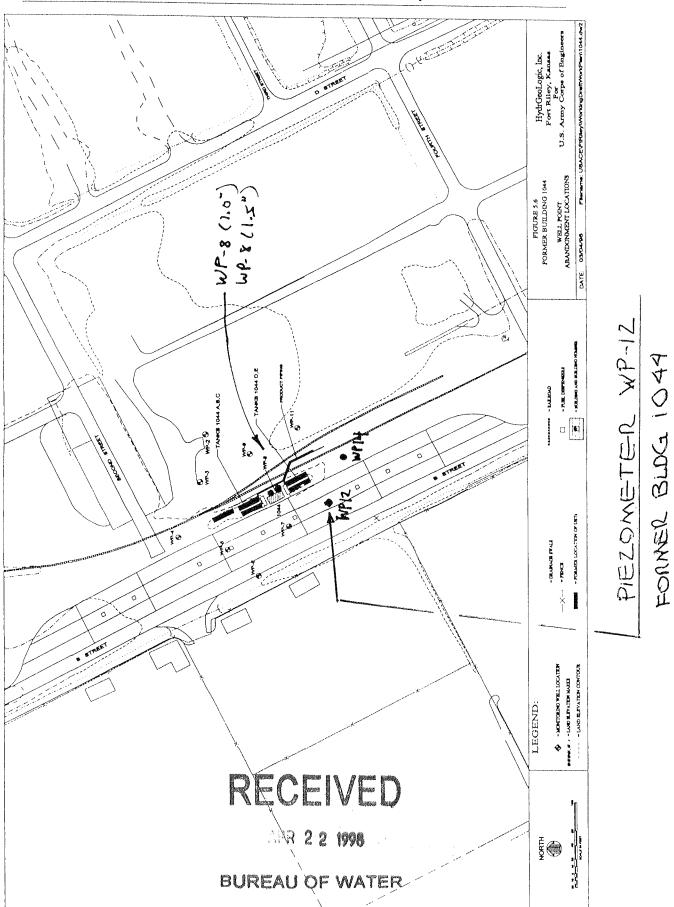

U.S. Army Corps of Engineers—Kansas City District