
	WATER WELL RECORD	Form WWC-5	KSA 82a	-1212		
LOCATION OF WATER WELL:	Fraction	MANUAL CO.	ion Number	Township I	Number	Range Number
County: SENCY	SW 1/4 NE 1/4	1/4		<u> </u>	S	R 6 ENV
Distance and direction from nearest town	n or city street address of well if loca	ated within city?				
F+ KILEY KS.	comp functions f	NUEU	BUDG	,1044	WI	7-14
	S ARMY CORPS					
	0/ E /274 ST	The state of the s	2,000-		Agricultura F	oivision of Water Resources
		406	•			Wision of Water Hesources
City, State, ZIP Code :	<<,MO, 64	799			n Number:	
LOCATE WELL'S LOCATION WITH 4						
N	Depth(s) Groundwater Encountered_					
	WELL'S STATIC WATER LEVEL	<b>-1,. 6</b> , ft. b∈	low land sur	face measured o	n mo/day/yr	37.6.79
ACS SEE	Pump test data: Well w	ater was	ft. af	fter	. hours pur	mping gpm
W W W W W W W W W W W W W W W W W W W	Est. Yield gpm: Well w				-	
' IVI'N II.	Bore Hole Diameter in.	Alex of M				
My Beautiful Control of the Control	WELL WATER TO BE USED AS:	5 Public water		8 Air conditionin		njection well
=   Amachain	1 Domestic 3 Feedlot				-	•
SW was as as SE as as		o Oil field wat	er suppry	9 Dewatering	27 6	Other (Specify below)
	2 Irrigation 4 Industrial	/ Lawn and g	arden only	TO Monitoring we	1163	DRAW J. C. F
	Was a chemical/bacteriological sampl	e submitted to De				mo/day/yr sample was sub-
ola S	mitted		Wat	ter Well Disinfect		No No
5 TYPE OF BLANK CASING USED:	5 Wrought iron	8 Concre	te tile	CASING JO	DINTS: Glued	Clamped
1 Steel 3 RMP (SR	6 Asbestos-Cemer	nt 9 Other (	specify below	v)	Welde	
PVC 4 ABS	7 Fiberglass				Threa	ded Feysh
Blank easing diameter						
Casing height above land surface						
TYPE OF SCREEN OR PERFORATION		7 PV	The state of the s		bestos-ceme	
		A CONTRACTOR OF THE PARTY OF TH	acceptant.			• • •
1 Steel 3 Stainless	3		P (SR)			4
2 Brass 4 Galvanize		9 ABS	•		one used (op	,
SCREEN OR PERFORATION OPENING	The state of the s	uzed wrapped		8 Saw cut		11 None (open hole)
1 Continuous slot 3 Mil	and the state of t	re wrapped		9 Drilled holes		
2 Louvered shutter 4 Ke	· ' ' ' ' ' ' ' ' ' ' ' ' ' ' ' ' ' ' '	rch cut		· ·		
SCREEN-PERFORATED INTERVALS:	From. 🦈 . I ft. to	and the second	ft Fror	m	ft. to	o
··		The state of the s				
	From ft. to				ft. to	<b>)</b> ft.
GRAVEL PACK INTERVALS:			ft., Fror	m		
	From ft. to	· · · · · · · · · · · · · · · · · · ·	ft., Fror	m	ft. to	oft.
GRAVEL PACK INTERVALS:	From.         ft. to           From.         ft. to           From         ft. to	And Englances additional control	ft., Fror ft., Fror ft., Fror	ท	ft. to	oft.

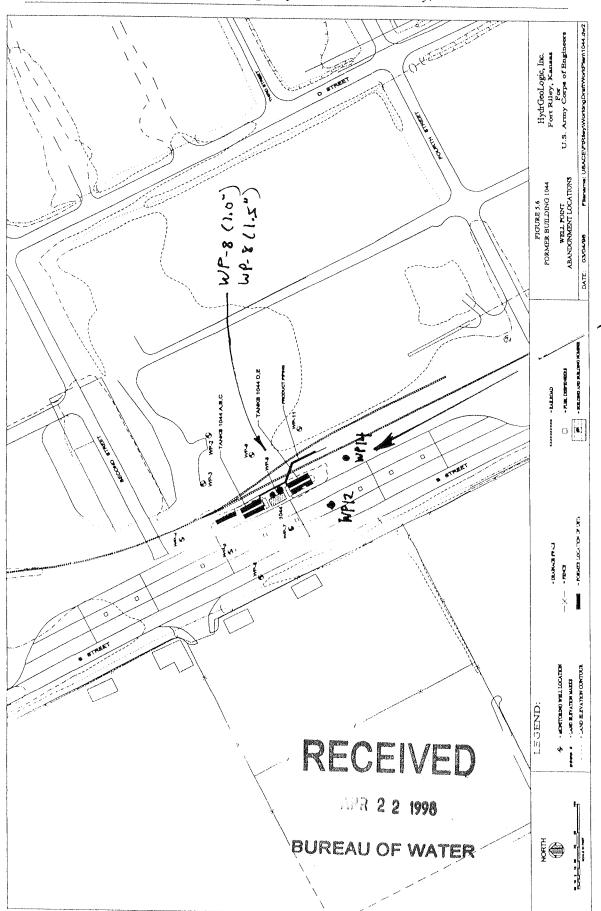

REZONETER WP-14

FORMER BUDG 10 44

U.S. Army Corps of Engineers—Kansas City District