

1	LOCATION OF WATER WELL:	Fraction	Section Number	Township Number	Range Number
	County: <u>GEARY</u>	<u>SW 1/4 NW 1/4</u> 1/4	<u>31</u>	<u>11 S</u>	<u>6 E</u>

Distance and direction from nearest town or city street address of well if located within city?  
FORT RILEY KS, CAMP FUNSTON FORMER BUDG 1637 WP-84

2	WATER WELL OWNER: <u>US ARMY CORPS of ENGINEERS</u>
	RR#, St. Address, Box #: <u>601 E 12TH ST</u>
	City, State, ZIP Code : <u>KC MO 64106</u>
	Board of Agriculture, Division of Water Resources Application Number:

3	MARK WELL'S LOCATION WITH AN "X" IN SECTION BOX: N	4	DEPTH OF WELL... <u>23.7</u> .....ft. WELL'S STATIC WATER LEVEL... <u>22.8</u> .....ft. WELL WAS USED AS: 1 Domestic 2 Irrigation 3 Feedlot 4 Industrial 5 Public Water Supply 6 Oil Field Water Supply 7 Lawn and Garden Only 8 Air Conditioning 9 Dewatering 10 Monitoring Well 11 Injection Well 12 Other..... <u>DIBZOMETER</u>												
<table border="1"> <tr><td colspan="2">PLEASE SEE</td></tr> <tr><td>N W</td><td>N E</td></tr> <tr><td>DWG</td><td></td></tr> <tr><td>W ATTACHED</td><td>E</td></tr> <tr><td>S W</td><td>S E</td></tr> <tr><td colspan="2">S</td></tr> </table>		PLEASE SEE		N W	N E	DWG		W ATTACHED	E	S W	S E	S		<p>Was a chemical/bacteriological sample submitted to Department? Yes.....No...          If yes, mo/day/yr sample was submitted.....          Water Well Disinfected: Yes..... No...<u>X</u></p>	
PLEASE SEE															
N W	N E														
DWG															
W ATTACHED	E														
S W	S E														
S															

5	TYPE OF BLANK CASING USED:
	1 Steel    3 RMP (SR)    5 Wrought    7 Fiberglass    9 Other (specify below) 2 PVC    4 ABS    6 Asbestos-Cement    8 Concrete Tile
	Blank casing diameter... <u>1</u> .....in.    Was casing pulled? Yes... <u>1</u> ... No..... If yes, how much... <u>6'</u> Casing height above or below land surface... <u>FLUSH MOUNTED</u> .....in.

6	GROUT PLUG MATERIAL: 1 Neat cement    2 Cement grout <u>3 Bentonite</u> 4 Other.....
	Grout Plug Intervals: From... <u>23.7</u> ...ft. to... <u>6</u> ...ft., From.....ft. to .....ft., From..... to.....ft.
	What is the nearest source of possible contamination: 1 Septic tank    6 Seepage pit    11 Fuel storage    16 Other (specify below) 2 Sewer lines    7 Pit privy    12 Fertilizer storage 3 Watertight sewer lines    8 Sewage lagoon    13 Insecticide storage 4 Lateral lines    9 Feedyard    14 Abandoned water well <u>FORMER UST SITE</u> 5 Cess Pool    10 Livestock pens    15 Oil well/Gas well
	Direction from well? .....    How many feet? .....

FROM	TO	PLUGGING MATERIALS
<u>23.7</u>	<u>3</u>	<u>bentonite</u>
<u>3</u>	<u>0</u>	<u>CLAY-NATIVE SOIL</u>

GEOPROBE GROUT PUMP  
 W TRASH LINE USED  
 FOR SLURRY ABANDONMENT

7	CONTRACTOR'S OR LANDOWNER'S CERTIFICATION: This water well was plugged under my jurisdiction and was completed on (mo/day/year)... <u>4-10-98</u> ..... and this record is true to the best of my knowledge and belief. Kansas Water Well Contractor's License No. ... <u>696</u> ..... This Water Well Record was completed on (mo/day/year) ... <u>4-14-98</u> ..... under the business name of <u>ESCC</u> ... <u>PSA SW, DBA</u> ..... by (signature) .....
---	--

INSTRUCTIONS: Use typewriter or ball point pen. Please press firmly and print clearly. Please fill in blanks, underline or circle the correct answers. Send top three copies to Kansas Department of Health and Environment, Bureau of Water, Topeka, Kansas 66620-0001. Telephone: 913/296-3565. Send one to Water Well Owner and retain one for your records.

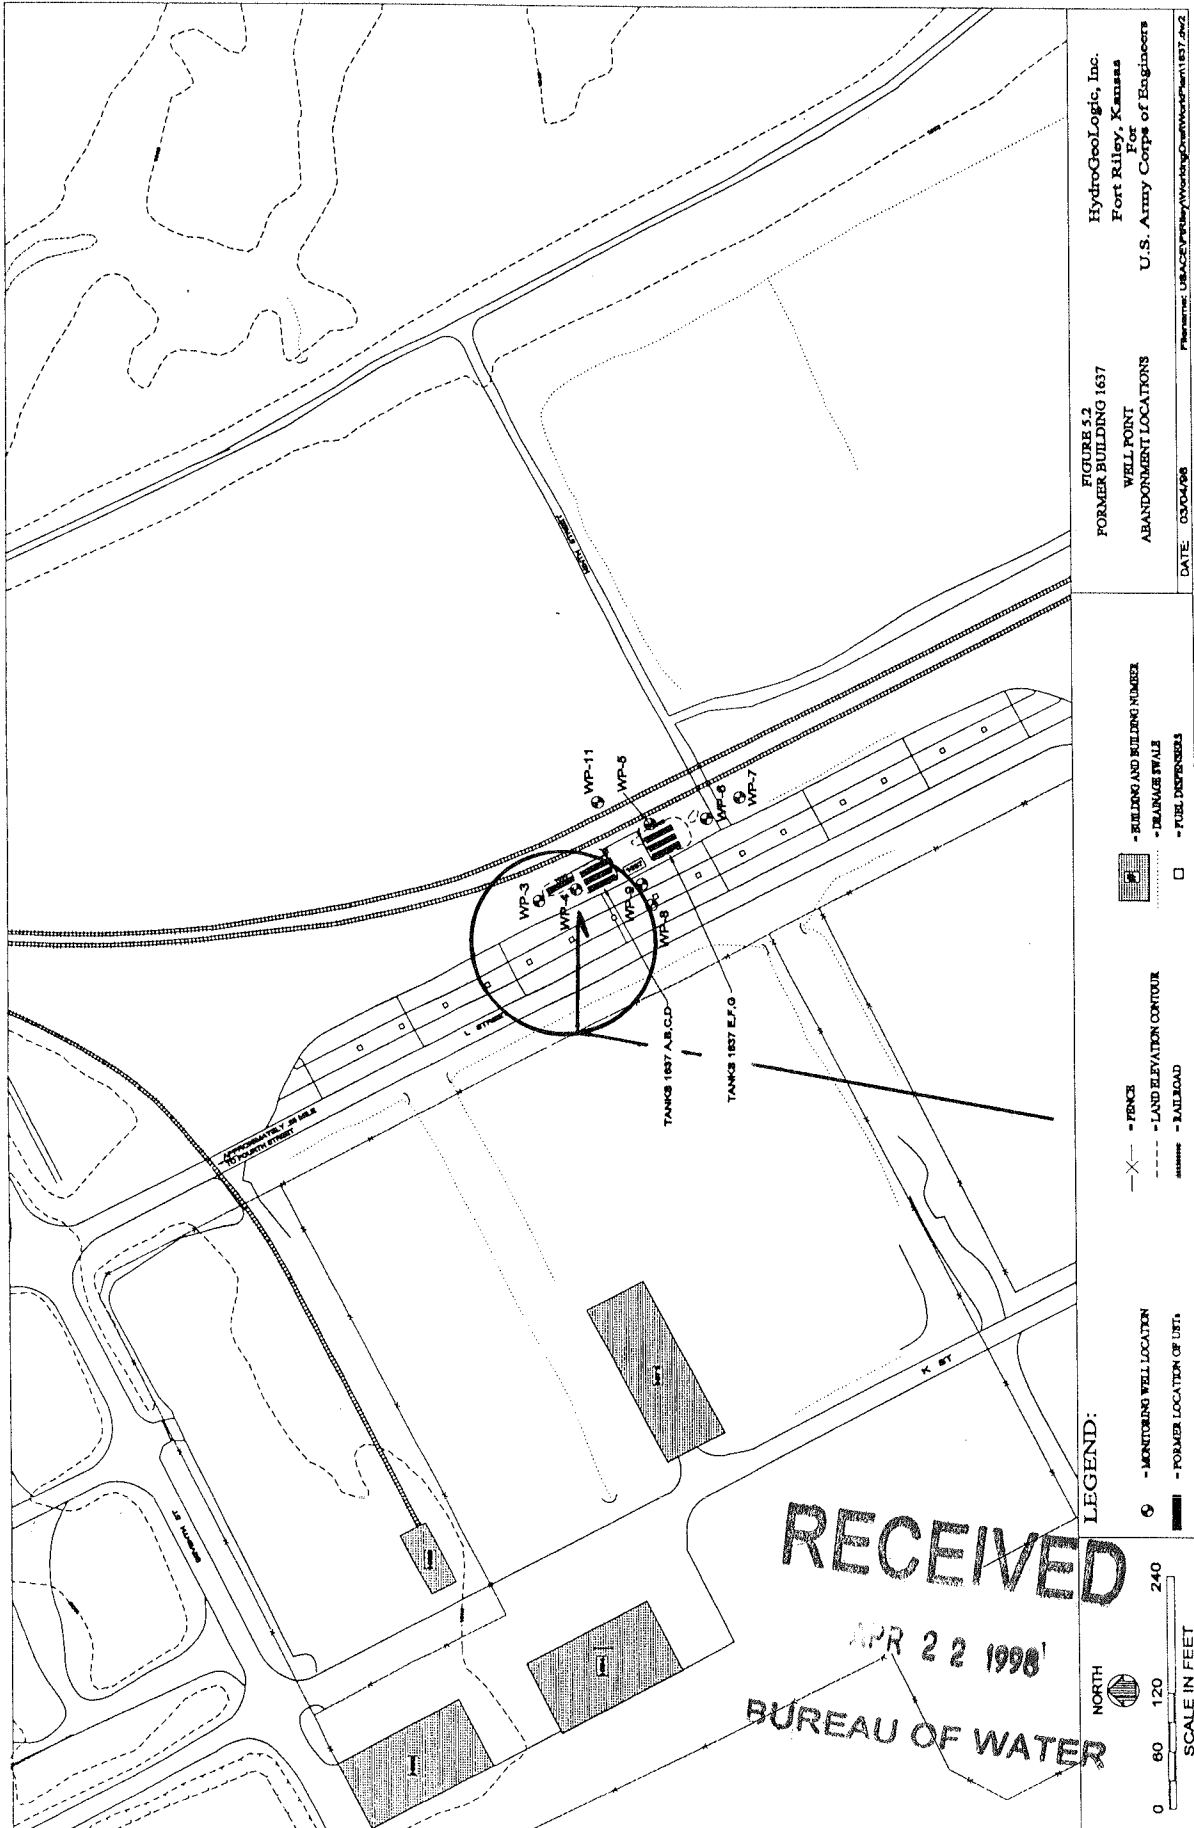


FIGURE 5.2  
FORMER BUILDING 1637  
WELL POINT  
ABANDONMENT LOCATIONS

HydroGeoLogic, Inc.  
Fort Riley, Kansas  
For  
U.S. Army Corps of Engineers

DATE: 03/04/98  
Filename: L:\RACE\FortRiley\Working\Drawn\WorkPlan1637.dwg

LEGEND:

- X- FENCE
- - - LAND ELEVATION CONTOUR
- DRAINAGE WALL
- RAILROAD
- MONITORING WELL LOCATION
- FORMER LOCATION OF USTs
- BUILDING AND BUILDING NUMBER
- DRAINAGE WALL
- FUEL DISPENSERS

PIEZOMETER WP-4  
FORMER BLDG 1637