

WATER WELL RECORD Form WWC-5 KSA 82a-1212


1 LOCATION OF WATER WELL: County: GOVY Fraction: SW 1/4 NW 1/4 Section Number: 31 Township Number: T 11 S Range Number: R 6 E/W

Distance and direction from nearest town or city street address of well if located within city?
Fort Riley KS CAMP FUNSTON FORMER BLDG 1637 WP-4

2 WATER WELL OWNER: US ARMY CORPS OF ENGINEERS
 RR#, St. Address, Box #: 601 E 12TH ST
 City, State, ZIP Code: KE, MO 64106
 Board of Agriculture, Division of Water Resources
 Application Number:

3 LOCATE WELL'S LOCATION WITH AN "X" IN SECTION BOX:

4 DEPTH OF COMPLETED WELL: 23.7 ft. ELEVATION: 1075.25
 Depth(s) Groundwater Encountered 1. 2.2 ft. 2. _____ ft. 3. _____ ft.
 WELL'S STATIC WATER LEVEL 21.5 ft. below land surface measured on mo/day/yr 3-3-95
 Pump test data: Well water was _____ ft. after _____ hours pumping _____ gpm
 Est. Yield _____ gpm: Well water was _____ ft. after _____ hours pumping _____ gpm
 Bore Hole Diameter: 1 in. to 23.7 ft., and _____ in. to _____ ft.
 WELL WATER TO BE USED AS: 5 Public water supply 8 Air conditioning 11 Injection well
 1 Domestic 3 Feedlot 6 Oil field water supply 9 Dewatering 12 Other (Specify below)
 2 Irrigation 4 Industrial 7 Lawn and garden only 10 Monitoring well PIEZOMETER
 Was a chemical/bacteriological sample submitted to Department? Yes _____ No X; If yes, mo/day/yr sample was sub-
 mitted Water Well Disinfected? Yes _____ No X

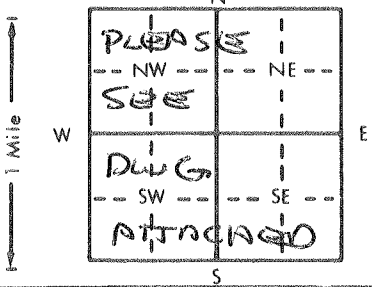

5 TYPE OF BLANK CASING USED: 1 Steel 3 RMP (SR) 6 Asbestos-Cement 9 Other (specify below) Welded _____
 2 PVC 4 ABS 7 Fiberglass _____ Threaded: FLUSH
 CASING JOINTS: Glued _____ Clamped _____

Blank casing diameter _____ in. to _____ ft., Dia _____ in. to _____ ft., Dia _____ in. to _____ ft.
 Casing height above land surface FLUSH in., weight _____ lbs./ft. Wall thickness or gauge No. SCH 40

TYPE OF SCREEN OR PERFORATION MATERIAL: 7 PVC 10 Asbestos-cement
 1 Steel 3 Stainless steel 5 Fiberglass 8 RMP (SR) 11 Other (specify) _____
 2 Brass 4 Galvanized steel 6 Concrete tile 9 ABS 12 None used (open hole)

SCREEN OR PERFORATION OPENINGS ARE: 5 Gauzed wrapped 8 Saw cut 11 None (open hole)
 1 Continuous slot 3 Mill slot 0.010 6 Wire wrapped 9 Drilled holes
 2 Louvered shutter 4 Key punched 7 Torch cut 10 Other (specify) _____

SCREEN-PERFORATED INTERVALS: From 23.7 ft. to 20.7 ft., From _____ ft. to _____ ft.
 From _____ ft. to _____ ft., From _____ ft. to _____ ft.
 GRAVEL PACK INTERVALS: From _____ ft. to _____ ft., From _____ ft. to _____ ft.
 From _____ ft. to _____ ft., From _____ ft. to _____ ft.

6 GROUT MATERIAL: 1 Neat cement 2 Cement grout 3 Bentonite 4 Other _____
 Grout Intervals: From 0 ft. to 3 ft., From _____ ft. to _____ ft., From _____ ft. to _____ ft.

What is the nearest source of possible contamination:
 1 Septic tank 4 Lateral lines 7 Pit privy 10 Livestock pens 14 Abandoned water well
 2 Sewer lines 5 Cess pool 8 Sewage lagoon 11 Fuel storage 15 Oil well/Gas well
 3 Watertight sewer lines 6 Seepage pit 9 Feedyard 12 Fertilizer storage 16 Other (specify below)
 13 Insecticide storage FORMER U.S.T. SITE
 How many feet? _____

FROM	TO	LITHOLOGIC LOG	FROM	TO	PLUGGING INTERVALS
<u>0</u>	<u>23.7</u>	<u>DIRECT PUSH INSTALLED</u>			
		<u>NO CUTTINGS</u>			

7 CONTRACTOR'S OR LANDOWNER'S CERTIFICATION: This water well was (1) constructed, (2) reconstructed, or (3) plugged under my jurisdiction and was completed on (mo/day/year) 3-2-95 and this record is true to the best of my knowledge and belief. Kansas Water Well Contractor's License No. 606 This Water Well Record was completed on (mo/day/yr) 4-14-98 under the business name of ESCC dba PSA ENV. by (signature) [Signature]

INSTRUCTIONS: Use typewriter or ball point pen. PLEASE PRESS FIRMLY and PRINT clearly. Please fill in blanks, underline or circle the correct answers. Send top three copies to Kansas Department of Health and Environment, Bureau of Water, Topeka, Kansas 66620-0001. Telephone: 913-296-5545. Send one to WATER WELL OWNER and retain one for your records.

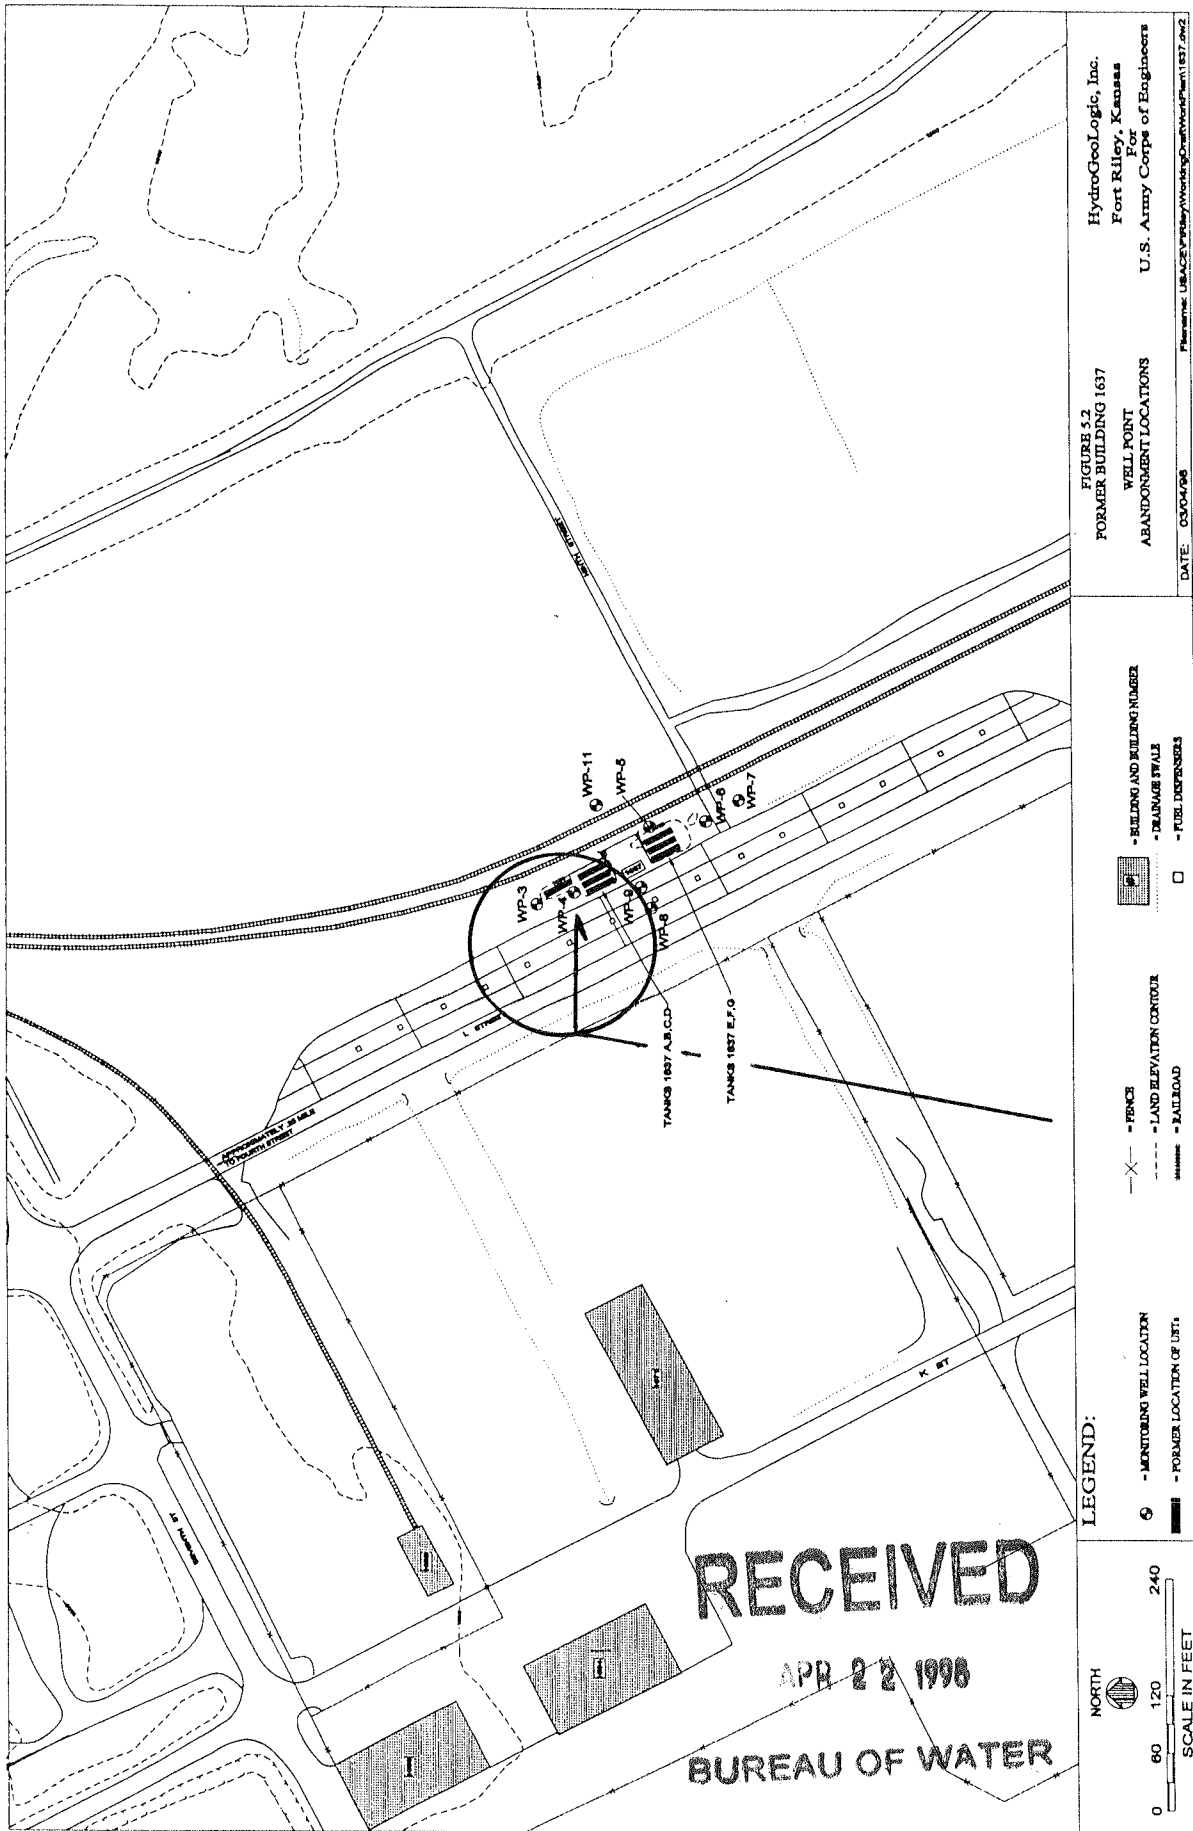


FIGURE 5.2
FORMER BUILDING 1637
WELL POINT
ABANDONMENT LOCATIONS

HydroGeoLogic, Inc.
Fort Riley, Kansas
For
U.S. Army Corps of Engineers

DATE: 03/04/98
Filename: L:\RACE\FortRiley\Working\Drawn\WorkPlan1637.dwg

LEGEND:

- X- FENCE
- MONITORING WELL LOCATION
- BUILDING AND BUILDING NUMBER
- - - DRAINAGE SWALE
- FUEL DISPENSERS
- - - LAND ELEVATION CONTOUR
- - - RAILROAD

PIEZOMETER WP-4
FORMER BLDG 1637

RECEIVED

APR 22 1998

BUREAU OF WATER