

County: Geary Fraction: SE SE NW SW Sec. 28 T. 11 S R. 6 E

CORRECTION(S) to WATER WELL COMPLETION RECORD Form WWC-5 (to rectify lacking or incorrect information)

Owner: Fort Riley (David Jones) 354-19-34

If location corrected, was listed as:	Location changed to:
Section-Township-Range: <u>none listed</u>	<u>28-11-6E</u>
Fraction (¼ calls): <u>none listed</u>	<u>SE SE NW SW</u>

Other changes: Initial statements: _____

Changed to: _____

Comments: _____

Verification method: Correct S-T-R and fractions found by entering Latitude and Longitude in LEOWEB.

Matched location with site map on the KGS mapper

Initials: SH Date: 01-27-2021

Submitted by: Kansas Geological Survey, Data Resources Library, 1930 Constant Ave., Lawrence, KS 66047-3724
 Kansas Dept. of Health & Environment, Bureau of Water, 1000 SW Jackson, Suite 420, Topeka, KS 66612-1367

WATER WELL RECORD Form WWC-5

Original Record Correction Change in Well Use

Division of Water Resources App. No.

Well ID **354-19-34**

1 LOCATION OF WATER WELL: County: Geary	Fraction ¼ ¼ ¼ ¼	Section Number	Township Number T S R	Range Number E W
--	---------------------	----------------	--------------------------	---------------------

2 WELL OWNER: Last Name: Jones First: David Business: Fort Riley Address: Sheridan Hall Building 407 Pershing Court City: Fort Riley State: KS ZIP: 66442	Street or Rural Address where well is located (if unknown, distance and direction from nearest town or intersection): If at owner's address, check here: <input type="checkbox"/> Fort Riley Building #354 Fort Riley, KS 66442
--	---

3 LOCATE WELL WITH "X" IN SECTION BOX: N W E S -----1 mile-----	4 DEPTH OF COMPLETED WELL: 40.0 ft. Depth(s) Groundwater Encountered: 1) 34 ft. 2) N/A ft. 3) N/A ft. or 4) <input type="checkbox"/> Dry Well WELL'S STATIC WATER LEVEL: 34.03 ft. <input checked="" type="checkbox"/> below land surface, measured on (mo-day-yr) 12-10-19 <input type="checkbox"/> above land surface, measured on (mo-day-yr) Pump test data: Well water was N/A ft. after N/A hours pumping N/A gpm Well water was N/A ft. after N/A hours pumping N/A gpm Estimated Yield: N/A gpm Bore Hole Diameter: 8.25 in. to 40.0 ft. and N/A in. to N/A ft.	5 Latitude: 39.0628321 (decimal degrees) Longitude: -96.7769047 (decimal degrees) Horizontal Datum: <input type="checkbox"/> WGS 84 <input checked="" type="checkbox"/> NAD 83 <input type="checkbox"/> NAD 27 Source for Latitude/Longitude: <input type="checkbox"/> GPS (unit make/model: (WAAS enabled? <input type="checkbox"/> Yes <input type="checkbox"/> No) <input checked="" type="checkbox"/> Land Survey <input type="checkbox"/> Topographic Map <input type="checkbox"/> Online Mapper:
--	---	--

7 WELL WATER TO BE USED AS:		
1. Domestic: <input type="checkbox"/> Household <input type="checkbox"/> Lawn & Garden <input type="checkbox"/> Livestock	2. <input type="checkbox"/> Irrigation 3. <input type="checkbox"/> Feedlot 4. <input type="checkbox"/> Industrial	5. <input type="checkbox"/> Public Water Supply: well ID 6. <input type="checkbox"/> Dewatering: how many wells? 7. <input type="checkbox"/> Aquifer Recharge: well ID 8. <input checked="" type="checkbox"/> Monitoring: well ID 354-19-34 9. Environmental Remediation: well ID <input type="checkbox"/> Air Sparge <input type="checkbox"/> Soil Vapor Extraction <input type="checkbox"/> Recovery <input type="checkbox"/> Injection
10. <input type="checkbox"/> Oil Field Water Supply: lease 11. Test Hole: well ID <input type="checkbox"/> Cased <input type="checkbox"/> Uncased <input type="checkbox"/> Geotechnical 12. Geothermal: how many bores? a) Closed Loop <input type="checkbox"/> Horizontal <input type="checkbox"/> Vertical b) Open Loop <input type="checkbox"/> Surface Discharge <input type="checkbox"/> Inj. of Water 13. <input type="checkbox"/> Other (specify):		

Was a chemical/bacteriological sample submitted to KDHE? Yes No If yes, date sample was submitted:
Water well disinfected? Yes No

8 TYPE OF CASING USED: <input type="checkbox"/> Steel <input checked="" type="checkbox"/> PVC <input type="checkbox"/> Other CASING JOINTS: <input type="checkbox"/> Glued <input type="checkbox"/> Clamped <input type="checkbox"/> Welded <input checked="" type="checkbox"/> Threaded Casing diameter 2 in. to 30.0 ft., Diameter N/A in. to N/A ft., Diameter N/A in. to N/A ft. Casing height above land surface 0 in. Weight N/A lbs./ft. Wall thickness or gauge No. Sch. 40	TYPE OF SCREEN OR PERFORATION MATERIAL: <input type="checkbox"/> Steel <input type="checkbox"/> Stainless Steel <input type="checkbox"/> Fiberglass <input checked="" type="checkbox"/> PVC <input type="checkbox"/> Other (Specify) <input type="checkbox"/> Brass <input type="checkbox"/> Galvanized Steel <input type="checkbox"/> Concrete tile <input type="checkbox"/> None used (open hole)
SCREEN OR PERFORATION OPENINGS ARE: <input type="checkbox"/> Continuous Slot <input checked="" type="checkbox"/> Mill Slot <input type="checkbox"/> Gauze Wrapped <input type="checkbox"/> Torch Cut <input type="checkbox"/> Drilled Holes <input type="checkbox"/> Other (Specify) <input type="checkbox"/> Louvered Shutter <input type="checkbox"/> Key Punched <input type="checkbox"/> Wire Wrapped <input type="checkbox"/> Saw Cut <input type="checkbox"/> None (Open Hole)	
SCREEN-PERFORATED INTERVALS: From 30.0 ft. to 40.0 ft., From N/A ft. to N/A ft., From N/A ft. to N/A ft. GRAVEL PACK INTERVALS: From 26.0 ft. to 40.0 ft., From N/A ft. to N/A ft., From N/A ft. to N/A ft.	


9 GROUT MATERIAL: <input type="checkbox"/> Neat cement <input checked="" type="checkbox"/> Cement grout <input checked="" type="checkbox"/> Bentonite <input checked="" type="checkbox"/> Other Concrete 0-2 feet Grout Intervals: From 2 ft. to 26.0 ft., From N/A ft. to N/A ft., From N/A ft. to N/A ft.	Nearest source of possible contamination: <input type="checkbox"/> Septic Tank <input type="checkbox"/> Lateral Lines <input type="checkbox"/> Pit Privy <input type="checkbox"/> Livestock Pens <input type="checkbox"/> Insecticide Storage <input type="checkbox"/> Sewer Lines <input type="checkbox"/> Cess Pool <input type="checkbox"/> Sewage Lagoon <input type="checkbox"/> Fuel Storage <input type="checkbox"/> Abandoned Water Well <input type="checkbox"/> Watertight Sewer Lines <input type="checkbox"/> Seepage Pit <input type="checkbox"/> Feedyard <input type="checkbox"/> Fertilizer Storage <input type="checkbox"/> Oil Well/Gas Well <input checked="" type="checkbox"/> Other (Specify) Solvent storage at former Building 354
Direction from well? Northeast Distance from well? 275 ft.	

10 FROM	TO	LITHOLOGIC LOG	FROM	TO	LITHO. LOG (cont.) or PLUGGING INTERVALS
		(Attached)			

11 CONTRACTOR'S OR LANDOWNER'S CERTIFICATION: This water well was constructed, reconstructed, or plugged under my jurisdiction and was completed on (mo-day-year) **12/10/2019** and this record is true to the best of my knowledge and belief. Kansas Water Well Contractor's License No. **759** This Water Well Record was completed on (mo-day-year) **1/8/2020** under the business name of **RAZEK Environmental, LLC** Signature *[Signature]*





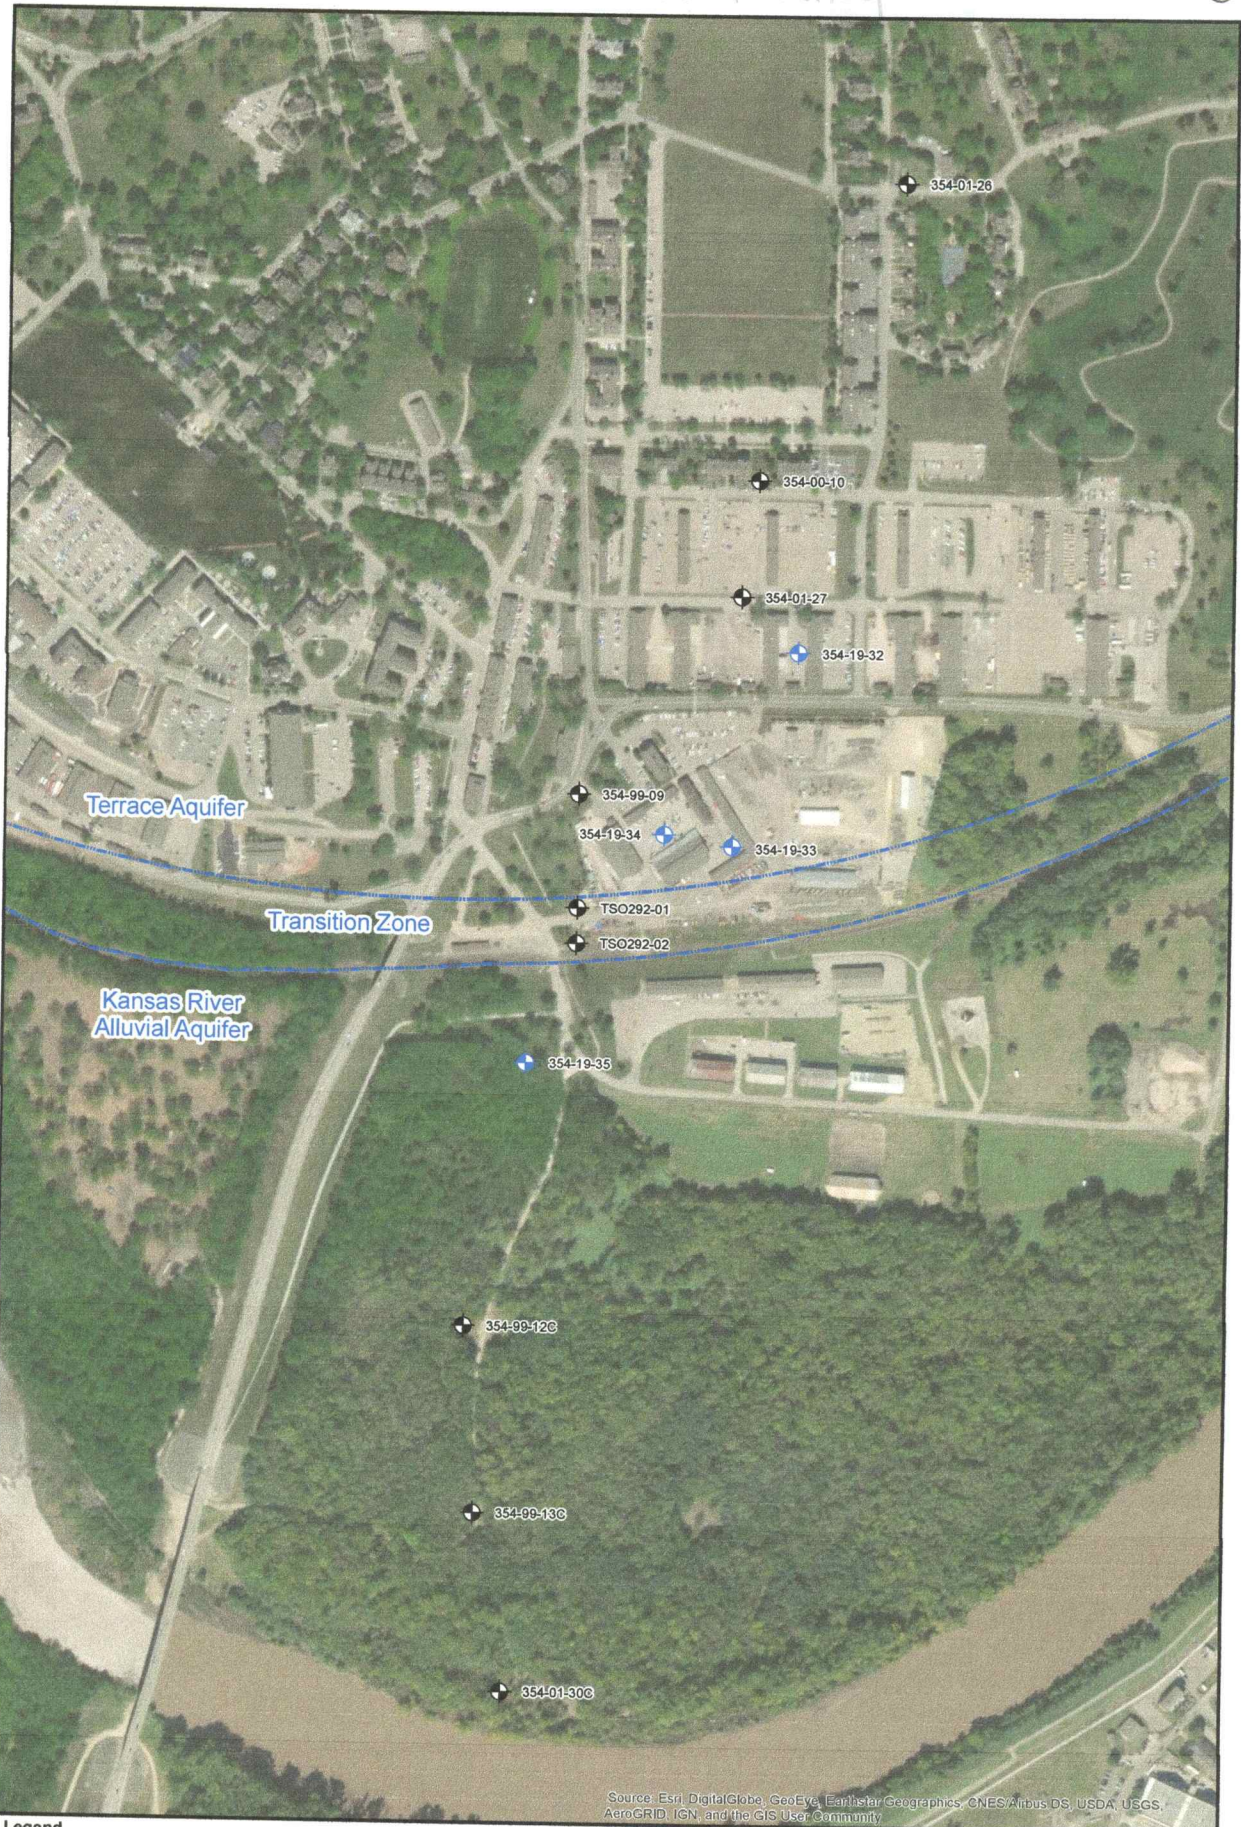

very

Fort Riley 28-11-6E



Path: Z:\Client\ENR\061117\308_BLDG54\Bldg54\Geospatial\Doc\Figures\17-1_354 Solvent Detection Area Well Location Map_UFP_QAPP.mxd
 COPYRIGHT © 2014 BURNS & MCDONNELL ENGINEERING COMPANY, INC.
 Issued: July, 12 2019

Source: Esri, DigitalGlobe, GeoEye, Earthstar Geographics, CNES/Airbus DS, USDA, USGS, AeroGRID, IGN, and the GIS User Community

<p>Legend</p> <ul style="list-style-type: none">  Proposed Monitoring Well  Existing Monitoring Well  Aquifer Boundary <div style="text-align: center;">   Feet </div>		<p>FIGURE 17-1 PROPOSED AND EXISTING MONITORING WELL LOCATION MAP 354 AREA SOLVENT DETECTIONS UFP-QAPP FORT RILEY, KANSAS</p>
---	--	--

nearby

Fort Riley

HTW DRILLING LOG

HOLE NO.
354-19-34
SHEET 1
OF 5 SHEETS

1. COMPANY NAME Burns + McDannell		2. DRILLING SUBCONTRACTOR RAZEK		
3. PROJECT 354 AREA Solvent Detections		4. LOCATION 354 Area Fort Riley		
5. NAME OF DRILLER Tony Poulter		6. MANUFACTURER'S DESIGNATION OF DRILL Geoprobe		
7. SIZES AND TYPES OF DRILLING AND SAMPLING EQUIPMENT	2" DPT Macdonald		8. HOLE LOCATION	
	8.25" HSA		9. SURFACE ELEVATION	
			10. DATE STARTED 12/16/19	
			11. DATE COMPLETED 12/16/19	
12. OVERBURDEN THICKNESS 39.8'		15. DEPTH GROUNDWATER ENCOUNTERED 33'		
13. DEPTH DRILLED INTO ROCK NA		16. DEPTH TO WATER AND ELAPSED TIME AFTER DRILING COMPLETED		
14. TOTAL DEPTH OF HOLE 39.8'		17. OTHER WATER LEVEL MEASUREMENTS (SPECIFY) NA		
18. GEOTECHNICAL SAMPLES NA	DISTURBED NA	UNDISTURBED NA	19. TOTAL NUMBER OF CORE BOXES NA	
20. SAMPLES FOR CHEMICAL ANALYSIS NA	VOC NA	METALS NA	OTHER (SPECIFY) NA	OTHER (SPECIFY) NA
				21. TOTAL CORE RECOVERY NA %
22. DISPOSITION OF HOLE MW installed	BACKFILLED NA	MONITORING WELL flush	OTHER (SPECIFY) NA	23. SIGNATURE OF INSPECTOR Dax Baker

ELEV. a	DEPTH b	DESCRIPTION OF MATERIALS c	FIELD SCREENING RESULTS d PID	GEOTECH SAMPLE OR CORE BOX NO. e	ANALYTICAL SAMPLE NO. f	BLOW COUNTS g	REMARKS h
	0	Asphalt / road bed		N/A	N/A	Recovery	Start Drilling 0915
	1	Sand, fine grain, yellowish brown 10YR (5/6), sub angular, damp, poorly graded, loose, quartz, Sp.	0.0				
	2		6.0				
	3		0.0				
	4	becomes very fine grain sand w/ trace silt, pale brown 10YR (6/3)	6.0				
	5		6.0			3/5	0918

HTW DRILLING LOG

HOLE NO.
354-19-34

SHEET 2
OF 5 SHEETS

PROJECT
354 AREA Solvent Detection

INSPECTOR
D. J. [Signature]

ELEV. a	DEPTH b	DESCRIPTION OF MATERIALS c	FIELD SCREENING RESULTS d PLD	GEOTECH SAMPLE OR CORE BOX NO. e	ANALYTICAL SAMPLE NO. f	BLOW COUNTS g	REMARKS h
	5		0.0			0	0918
	6	same Fe. oxide staining	0.0				
	7		0.0				
	8		0.0				
	9		0.0				
	10		0.0			35	0920
	11		0.0				0921
	12		0.0				
	13		0.0				
	14		0.0				

Wearry

fort Riley

HTW DRILLING LOG

HOLE NO.
354-A-34

PROJECT
354 Area Solvent Detections

INSPECTOR
Dax BK

SHEET 3
OF 5 SHEETS

ELEV. a	DEPTH b	DESCRIPTION OF MATERIALS c	FIELD SCREENING RESULTS d	GEOTECH SAMPLE OR CORE BOX NO. e	ANALYTICAL SAMPLE NO. f	BLOW COUNTS g	REMARKS h
	14		0.0				
	15		0.0			4.5/5	0925 0926
	16	becomes fine grain sand	0.0				
	17		0.0				
	18		0.0				
	19		0.0				
	20		0.0			3/5	0930 0931
	21	become very fine grain sand	0.0				
	22		0.0				
	23		0.0				

seary

Fort Killeen

HTW DRILLING LOG

HOLE NO.
354-19-34

PROJECT
354 Area Solvent Detection

INSPECTOR
Dy B

SHEET 4
OF 5 SHEETS

ELEV. a	DEPTH b	DESCRIPTION OF MATERIALS c	FIELD SCREENING RESULTS d	GEOTECH SAMPLE OR CORE BOX NO. e	ANALYTICAL SAMPLE NO. f	BLOW COUNTS g	REMARKS h
	23		6.0				
	24		6.0				
	25		6.0			415	0935 0936
	26		6.0				
	27		6.0				
	28		6.0				
	29	Silt w/ some very fine grain sand, Strong brown 7.5% (3/6), trace plasticity, soft, damp, SM.	6.0				
	30		0.0			415	0939 0941
	31						
	32						

Wearry

for Riley

HTW DRILLING LOG

HOLE NO.
354-19-34

SHEET 5
OF 5 SHEETS

PROJECT
354 Area Solvent Detections

INSPECTOR
D. B. Bl

ELEV. a	DEPTH b	DESCRIPTION OF MATERIALS c	FIELD SCREENING RESULTS d	GEOTECH SAMPLE OR CORE BOX NO. e	ANALYTICAL SAMPLE NO. f	BLOW COUNTS Reg'd.	REMARKS h
	32		0.0				
	33	becomes wet	0.0				7
	34	Sand, fine to medium grain, grayish brown 2.5 Y(5/2), subangular, loose, soft, well graded, wet SW.	0.0				
	35		0.0			415	0944 0946
	36		0.0				
	37		0.0				
	38	with some gravel	0.0				
	39		0.0				
		TD: 39.8'					Stop 0950 Refusal 39.8'