


1 LOCATION OF WATER WELL: County: ~~Butler~~ Geary Fraction: SW 1/4 SW 1/4 SW 1/4 Section Number: 28 Township Number: T 11 S Range Number: R 6 E

Distance and direction from nearest town or city street address of well if located within city?
IMPACT AREA WELLS - NO LEGAL AVAILABLE

2 WATER WELL OWNER: U.S. ARMY Board of Agriculture, Division of Water Resource
 RR#, St. Address, Box #: FORT RILEY KS Application Number: IA MW 9

3 LOCATE WELL'S LOCATION WITH AN "X" IN SECTION BOX: 4 DEPTH OF COMPLETED WELL: 42.5 ft. ELEVATION: ...

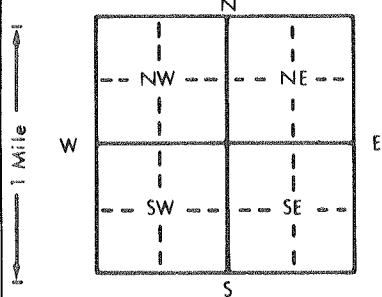

Depth(s) Groundwater Encountered: 1. ... ft. 2. ... ft. 3. ... ft.
 WELL'S STATIC WATER LEVEL: 99.9 ft. below land surface measured on mo/day/yr ...
 Pump test data: Well was ... ft. after ... hours pumping ... gpm
 Est. Yield ... gpm: Well water was ... ft. after ... hours pumping ... gpm
 Bore Hole Diameter: 6 in. to 42.5 ft., and 10 in. to 29 ft.
 WELL WATER TO BE USED AS: 5 Public water supply 8 Air conditioning 11 Injection well
 1 Domestic 3 Feedlot 6 Oil field water supply 9 Dewatering 12 Other (Specify below)
 2 Irrigation 4 Industrial 7 Lawn and garden only 10 Monitoring well
 Was a chemical/bacteriological sample submitted to Department? Yes ... No ... If yes, mo/day/yr sample was submitted ...
 Water Well Disinfected? Yes ... No ...

5 TYPE OF BLANK CASING USED: 1 Steel 3 RMP (SR) 5 Wrought iron 8 Concrete tile CASING JOINTS: Glued ... Clamped ...
 2 PVC 4 ABS 7 Fiberglass 9 Other (specify below) Welded ...
 Threaded ...
 Blank casing diameter: 2 in. to 32.5 ft., Dia 6 in. to 29 ft., Dia ... in. to ... ft.
 Casing height above land surface: 24 in., weight ... lbs./ft. Wall thickness or gauge No. ...

TYPE OF SCREEN OR PERFORATION MATERIAL: 1 Steel 3 Stainless steel 5 Fiberglass 8 RMP (SR) 11 Other (specify) ...
 2 Brass 4 Galvanized steel 6 Concrete tile 9 ABS 12 None used (open hole)

SCREEN OR PERFORATION OPENINGS ARE: 1 Continuous slot 3 Mill slot 5 Gauzed wrapped 8 Saw cut 11 None (open hole)
 2 Louvered shutter 4 Key punched 6 Wire wrapped 9 Drilled holes
 7 Torch cut 10 Other (specify) ...

SCREEN-PERFORATED INTERVALS: From 32.5 ft. to 42.5 ft., From ... ft. to ... ft.
 GRAVEL PACK INTERVALS: From 30.5 ft. to 42.5 ft., From ... ft. to ... ft.

6 GROUT MATERIAL: 1 Neat cement 2 Cement grout 3 Bentonite 4 Other ...
 Grout Intervals: From 0 ft. to 30.5 ft., From ... ft. to ... ft., From ... ft. to ... ft.

What is the nearest source of possible contamination: 1 Septic tank 4 Lateral lines 7 Pit privy 10 Livestock pens 14 Abandoned water well
 2 Sewer lines 5 Cess pool 8 Sewage lagoon 11 Fuel storage 15 Oil well/Gas well
 3 Watertight sewer lines 6 Seepage pit 9 Feedyard 12 Fertilizer storage 16 Other (specify below)
 Direction from well? WITHIN How many feet? WITHIN

FROM	TO	LITHOLOGIC LOG	FROM	TO	PLUGGING INTERVALS
0	TD	ALTERNATING LAYER CLAY, SHALE + LIME STONE			

7 CONTRACTOR'S OR LANDOWNER'S CERTIFICATION: This water well was (1) constructed, (2) reconstructed, or (3) plugged under my jurisdiction and was completed on (mo/day/year) 7/12/93 and this record is true to the best of my knowledge and belief, Kansas Water Well Contractor's License No. 102 This Water Well Record was completed on (mo/day/yr) 8/10 under the business name of LAYNE INC by (signature) B. Meier