


1 LOCATION OF WATER WELL: County: Riley Gears Fraction SW 1/4 SW 1/4 Section Number 28 Township Number T 11 S Range Number R 6 EW

Distance and direction from nearest town or city street address of well if located within city? Impact Area Wells - no legals available

2 WATER WELL OWNER: U. S. Army RR#, St. Address, Box #: Fort Riley Ks 66442 City, State, ZIP Code: Board of Agriculture, Division of Water Resource Application Number: IA MW 12

3 LOCATE WELL'S LOCATION WITH AN "X" IN SECTION BOX:

4 DEPTH OF COMPLETED WELL: 48.5 ft. ELEVATION: WELL'S STATIC WATER LEVEL: 28 ft. below land surface measured on mo/day/yr

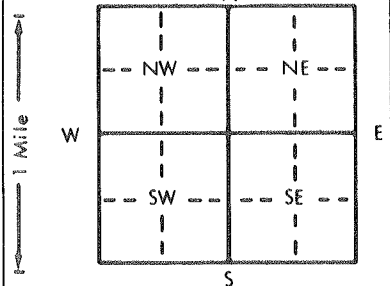

Depth(s) Groundwater Encountered: 1. ft. 2. ft. 3. ft. Pump test data: Well water was ... ft. after ... hours pumping ... gpm Est. Yield ... gpm: Well water was ... ft. after ... hours pumping ... gpm Bore Hole Diameter: 6 in. to 48.5 ft., and 10 in. to 25 ft. WELL WATER TO BE USED AS: 5 Public water supply 8 Air conditioning 11 Injection well 1 Domestic 3 Feedlot 6 Oil field water supply 9 Dewatering 12 Other (Specify below) 2 Irrigation 4 Industrial 7 Lawn and garden only 10 Monitoring well

5 TYPE OF BLANK CASING USED: 1 Steel 3 RMP (SR) 5 Wrought iron 8 Concrete tile CASING JOINTS: Glued ... Clamped ... 2 PVC 4 ABS 6 Asbestos-Cement 9 Other (specify below) Welded ... Threaded ...

Blank casing diameter: 2 in. to 38.5 ft., Dia: 6 in. to 25 ft., Dia: in. to in. Casing height above land surface: 24 in., weight lbs./ft. Wall thickness or gauge No.

TYPE OF SCREEN OR PERFORATION MATERIAL: 1 Steel 3 Stainless steel 5 Fiberglass 8 RMP (SR) 10 Asbestos-cement 2 Brass 4 Galvanized steel 6 Concrete tile 9 ABS 11 Other (specify) 12 None used (open hole)

SCREEN OR PERFORATION OPENINGS ARE: 1 Continuous slot 3 Mill slot 5 Gauzed wrapped 8 Saw cut 11 None (open hole) 2 Louvered shutter 4 Key punched 6 Wire wrapped 9 Drilled holes 10 Other (specify)

SCREEN-PERFORATED INTERVALS: From 38.5 ft. to 48.5 ft. GRAVEL PACK INTERVALS: From 36.5 ft. to 48.5 ft.

6 GROUT MATERIAL: 1 Neat cement 2 Cement grout 3 Bentonite 4 Other Grout Intervals: From 0 ft. to 36.5 ft.

What is the nearest source of possible contamination: 1 Septic tank 4 Lateral lines 7 Pit privy 10 Livestock pens 14 Abandoned water well 2 Sewer lines 5 Cess pool 8 Sewage lagoon 11 Fuel storage 15 Oil well/Gas well 3 Watertight sewer lines 6 Seepage pit 9 Feedyard 12 Fertilizer storage 16 Other (specify below) 13 Insecticide storage Impact area

Direction from well? within How many feet? within

FROM	TO	LITHOLOGIC LOG	FROM	TO	PLUGGING INTERVALS
0	TD	alternating layers of clay shale and limestone			

7 CONTRACTOR'S OR LANDOWNER'S CERTIFICATION: This water well was (1) constructed, (2) reconstructed, or (3) plugged under my jurisdiction and was completed on (mo/day/year) 07/12/93 and this record is true to the best of my knowledge and belief. Kansas Water Well Contractor's License No. 102 This Water Well Record was completed on (mo/day/yr) 8/10/93 under the business name of Layne, Inc. Wichita Ks by (signature) B. Meier