


1 LOCATION OF WATER WELL: Fraction SW 1/4 SW 1/4 SW 1/4 Section Number 27 Township Number T 11 S Range Number R 6 E
 County: Riley County
 Distance and direction from nearest town or city street address of well if located within city? MAAF MW 4

2 WATER WELL OWNER: U.S. Army
 RR#, St. Address, Box #: DEH Board of Agriculture, Division of Water Resources
 City, State, ZIP Code: 7th Riley KS 66442 Application Number:

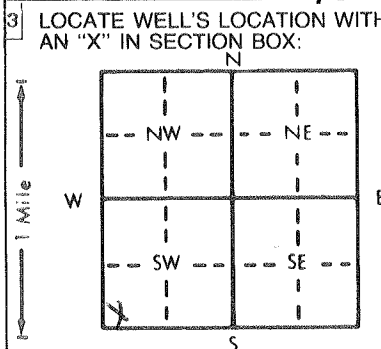

4 DEPTH OF COMPLETED WELL: 31 ft. ELEVATION:
 Depth(s) Groundwater Encountered 1. _____ ft. 2. _____ ft. 3. _____ ft.
 WELL'S STATIC WATER LEVEL: 10 ft. below land surface measured on mo/day/yr
 Pump test data: Well water was _____ ft. after _____ hours pumping _____ gpm
 Est. Yield _____ gpm: Well water was _____ ft. after _____ hours pumping _____ gpm
 Bore Hole Diameter: 8 in. to 31 ft., and _____ in. to _____ ft.
 WELL WATER TO BE USED AS: 5 Public water supply 8 Air conditioning 11 Injection well
 1 Domestic 3 Feedlot 6 Oil field water supply 9 Dewatering 12 Other (Specify below)
 2 Irrigation 4 Industrial 7 Lawn and garden only 10 Monitoring well
 Was a chemical/bacteriological sample submitted to Department? Yes _____ No ✓; If yes, mo/day/yr sample was submitted
 Water Well Disinfected? Yes _____ No ✓

5 TYPE OF CASING USED: 5 Wrought iron 8 Concrete tile CASING JOINTS: Glued _____ Clamped _____
 1 Steel 3 RMP (SR) 6 Asbestos-Cement 9 Other (specify below) Welded _____
2 PVC 4 ABS 7 Fiberglass _____ Threaded ✓
 Blank casing diameter: 2 in. to 6 ft., Dia _____ in. to _____ ft., Dia _____ in. to _____ ft.
 Casing height above land surface: 30 in., weight _____ lbs./ft. Wall thickness or gauge No. _____
 TYPE OF SCREEN OR PERFORATION MATERIAL: 10 Asbestos-cement
 1 Steel 3 Stainless steel 5 Fiberglass 7 PVC 8 RMP (SR) 11 Other (specify) _____
 2 Brass 4 Galvanized steel 6 Concrete tile 9 ABS 12 None used (open hole)
 SCREEN OR PERFORATION OPENINGS ARE: 5 Gauzed wrapped 8 Saw cut 11 None (open hole)
 1 Continuous slot 3 Mill slot 6 Wire wrapped 9 Drilled holes
 2 Louvered shutter 4 Key punched 7 Torch cut 10 Other (specify) _____
 SCREEN-PERFORATED INTERVALS: From 6 ft. to 31 ft., From _____ ft. to _____ ft.
 From _____ ft. to _____ ft., From _____ ft. to _____ ft.
 GRAVEL PACK INTERVALS: From 4 ft. to 31 ft., From _____ ft. to _____ ft.
 From _____ ft. to _____ ft., From _____ ft. to _____ ft.

6 GROUT MATERIAL: 1 Neat cement 2 Cement grout 3 Bentonite 4 Other _____
 Grout Intervals: From 0 ft. to 4 ft., From _____ ft. to _____ ft., From _____ ft. to _____ ft.
 What is the nearest source of possible contamination: 10 Livestock pens 14 Abandoned water well
 1 Septic tank 4 Lateral lines 7 Pit privy 11 Fuel storage 15 Oil well/Gas well
 2 Sewer lines 5 Cess pool 8 Sewage lagoon 12 Fertilizer storage 16 Other (specify below)
 3 Watertight sewer lines 6 Seepage pit 9 Feedyard 13 Insecticide storage AIRFIELD
 Direction from well? W/IN How many feet? W/IN

FROM		TO		LITHOLOGIC LOG	FROM	TO	PLUGGING INTERVALS
0	5			SILTY CLAY			
5	TD			SILTY SAND			

7 CONTRACTOR'S OR LANDOWNER'S CERTIFICATION: This water well was (1) constructed, (2) reconstructed, or (3) plugged under my jurisdiction and was completed on (mo/day/year) 8/22/94 and this record is true to the best of my knowledge and belief. Kansas Water Well Contractor's License No. 581 This Water Well Record was completed on (mo/day/yr) 8/22/94 under the business name of Rayne Inc Wichita by (signature) [Signature]