


1 LOCATION OF WATER WELL: County: Riley Geary Fraction: SW 1/4 SW 1/4 SW 1/4 Section Number: 27 Township Number: T 1 S Range Number: R 60 EW

2 WATER WELL OWNER: U.S. Army RR#: DEH City, State, ZIP Code: Ft Riley Ks 66442 Board of Agriculture, Division of Water Resources Application Number: MAAF MW 3

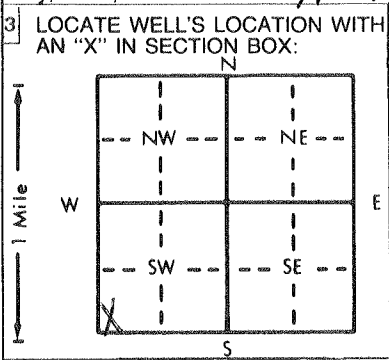

4 DEPTH OF COMPLETED WELL: 24 ft. ELEVATION: ... Depth(s) Groundwater Encountered: 1. 10 ft. 2. ... ft. 3. ... ft. WELL'S STATIC WATER LEVEL: 10 ft. below land surface measured on mo/day/yr

5 TYPE OF BLANK CASING USED: 2 PVC, 30 in., weight 4 lbs./ft. TYPE OF SCREEN OR PERFORATION MATERIAL: 7 PVC, 3 Mill slot, 4 Key punched. SCREEN-PERFORATED INTERVALS: From 4 ft. to 24 ft. GRAVEL PACK INTERVALS: From 3 ft. to 24 ft.

6 GROUT MATERIAL: 1 Neat cement, 3 ft. Grout intervals: From 0 ft. to 3 ft. What is the nearest source of possible contamination: 13 Insecticide storage, AIR FIELD.

Table with 4 columns: FROM, TO, LITHOLOGIC LOG, PLUGGING INTERVALS. Row 1: FROM 0 TO 5 SILTY CLAY. Row 2: FROM 5 TO 24 SILTY SAND.

7 CONTRACTOR'S OR LANDOWNER'S CERTIFICATION: This water well was (1) constructed, (2) reconstructed, or (3) plugged under my jurisdiction and was completed on (mo/day/year) 8/22/94 and this record is true to the best of my knowledge and belief. Kansas Water Well Contractor's License No. 102 This Water Well Record was completed on (mo/day/yr) 8/22/94 under the business name of Layne 581 Wichita by (signature) [Signature]

INSTRUCTIONS: Use typewriter or ball point pen. PLEASE PRESS FIRMLY and PRINT clearly. Please fill in blanks, underline or circle the correct answers. Send top three copies to Kansas Department of Health and Environment, Bureau of Water, Topeka, Kansas 66620-0001. Telephone: 913-296-5545. Send one to WATER WELL OWNER and retain one for your records.