


1 LOCATION OF WATER WELL: County: Riley Fraction: SW 1/4 NE 1/4 S0 1/4 Section Number: 29 Township Number: T 11 S Range Number: R 6 E
 Distance and direction from nearest town or city street address of well if located within city? 13006 180 MW 17

2 WATER WELL OWNER: U. S. Army
 RR#, St. Address, Box # : DEH # Riley Ks 66442
 City, State, ZIP Code : DEH # Riley Ks 66442
 Board of Agriculture, Division of Water Resource Application Number:

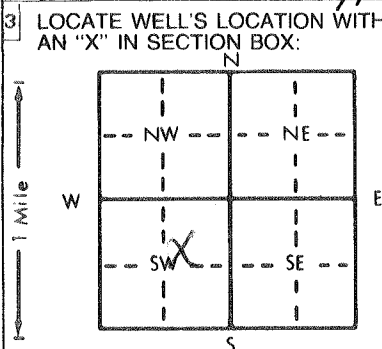

4 DEPTH OF COMPLETED WELL: 98 ft. ELEVATION:ft.
 Depth(s) Groundwater Encounteredft. 2.ft. 3.ft.
 WELL'S STATIC WATER LEVEL: 80 ft. below land surface measured on mo/day/yrft.
 Pump test data: Well water wasft. after hours pumping gpm
 Est. Yield gpm; Well water wasft. after hours pumping gpm
 Bore Hole Diameter: 6 in. to 9.8 in. toft. andin. toft.
 WELL WATER TO BE USED AS:
 1 Domestic 3 Feedlot 6 Oil field water supply 8 Air conditioning 11 Injection well
 2 Irrigation 4 Industrial 7 Lawn and garden only 10 Monitoring well 12 Other (Specify below)
 Was a chemical/bacteriological sample submitted to Department? Yes.....No.....
 If yes, mo/day/yr sample was submitted Water Well Disinfected? Yes No

5 TYPE OF CASING USED:
 1 Steel 3 RMP (SR) 5 Wrought iron 8 Concrete tile CASING JOINTS: Glued Clamped
2 PVC 4 ABS 6 Asbestos-Cement 9 Other (specify below) Welded
 7 Fiberglass Threaded.....
 Blank casing diameter: 2 in. to 8.8 in. toft., Diain. toft.
 Casing height above land surface: 30 in., weight lbs./ft. Wall thickness or gauge No.
 TYPE OF SCREEN OR PERFORATION MATERIAL:
 1 Steel 3 Stainless steel 5 Fiberglass 7 PVC 10 Asbestos-cement
 2 Brass 4 Galvanized steel 6 Concrete tile 8 RMP (SR) 11 Other (specify)
 12 None used (open hole)
 SCREEN OR PERFORATION OPENINGS ARE:
 1 Continuous slot 3 Mill slot 5 Gauzed wrapped 8 Saw cut 11 None (open hole)
 2 Louvered shutter 4 Key punched 6 Wire wrapped 9 Drilled holes
 7 Torch cut 10 Other (specify)
 SCREEN-PERFORATED INTERVALS: From 88 ft. to 98 ft., Fromft. toft.
 Fromft. toft., Fromft. toft.
 GRAVEL PACK INTERVALS: From 86 ft. to 98 ft., Fromft. toft.
 Fromft. toft., Fromft. toft.

6 GROUT MATERIAL: 1 Neat cement 2 Cement grout 3 Bentonite 4 Other
 Grout Intervals: From 0 ft. to 86 ft., Fromft. toft., Fromft. toft.
 What is the nearest source of possible contamination:
 1 Septic tank 4 Lateral lines 7 Pit privy 10 Livestock pens 14 Abandoned water well
 2 Sewer lines 5 Cess pool 8 Sewage lagoon 11 Fuel storage 15 Oil well/Gas well
 3 Watertight sewer lines 6 Seepage pit 9 Feedyard 12 Fertilizer storage 16 Other (specify below)
 Direction from well? WIN How many feet? WIN
DRY CLEANER

FROM	TO	LITHOLOGIC LOG	FROM	TO	PLUGGING INTERVALS
<u>0</u>	<u>TD</u>	<u>SIGY CLAY + SHALE</u> <u>w/ some L.S.</u>			

7 CONTRACTOR'S OR LANDOWNER'S CERTIFICATION: This water well was (1) constructed, (2) reconstructed, or (3) plugged under my jurisdiction and was completed on (mo/day/year) 8/22/94 and this record is true to the best of my knowledge and belief. Kansas Water Well Contractor's License No. 102-531 This Water Well Record was completed on (mo/day/yr) 8/22/94 under the business name of Royce Wichita by (signature) Royce