


1 LOCATION OF WATER WELL: Fraction * See Below Section Number Township Number Range Number
 County: GEARY SW 1/4 SW 1/4 SW 1/4 28 T 11 S R 6 EW

Distance and direction from nearest town or city street address of well if located within city?
1/2 Block South of Second St. on B St. Camp Funston, Ft. Riley, KS 1044 MW 94-4

2 WATER WELL OWNER: U.S. Army Corps of Engineers
 RR#, St. Address, Box # : 601 East 12th St. Board of Agriculture, Division of Water Resource
 City, State, ZIP Code : Kansas City, MO 64106 Application Number:

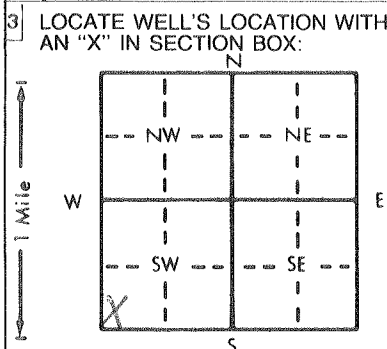

4 DEPTH OF COMPLETED WELL: 32 ft. ELEVATION:
 Depth(s) Groundwater Encountered 1. 24.5 ft. 2. ft. 3. ft.
 WELL'S STATIC WATER LEVEL .20 ft. below land surface measured on mo/day/yr 12/15/94
 Pump test data: Well water was ft. after hours pumping gpm
 Est. Yield gpm: Well water was ft. after hours pumping gpm
 Bore Hole Diameter: 10.5 in. to 32 ft., and in. to ft.
 WELL WATER TO BE USED AS: 5 Public water supply 8 Air conditioning 11 Injection well
 1 Domestic 3 Feedlot 6 Oil field water supply 9 Dewatering 12 Other (Specify below)
 2 Irrigation 4 Industrial 7 Lawn and garden only 10 Monitoring well
 Was a chemical/bacteriological sample submitted to Department? Yes No; If yes, mo/day/yr sample was submitted
 Water Well Disinfected? Yes No

5 TYPE OF BLANK CASING USED: 5 Wrought iron 8 Concrete tile CASING JOINTS: Glued Clamped
 1 Steel 3 RMP (SR) 6 Asbestos-Cement 9 Other (specify below) Welded
2 PVC 4 ABS 7 Fiberglass Threaded X
 Blank casing diameter 2 in. to 17 ft., Dia in. to ft., Dia in. to ft.
 Casing height above land surface 3 in., weight Flush Mount Cover lbs./ft. Wall thickness or gauge No. Sch 40

TYPE OF SCREEN OR PERFORATION MATERIAL: 7 PVC 10 Asbestos-cement
 1 Steel 3 Stainless steel 5 Fiberglass 8 RMP (SR) 11 Other (specify)
 2 Brass 4 Galvanized steel 6 Concrete tile 9 ABS 12 None used (open hole)

SCREEN OR PERFORATION OPENINGS ARE: 5 Gauzed wrapped 8 Saw cut 11 None (open hole)
 1 Continuous slot 3 Mill slot 6 Wire wrapped 9 Drilled holes
 2 Louvered shutter 4 Key punched 7 Torch cut 10 Other (specify)

SCREEN-PERFORATED INTERVALS: From 33 ft. to 18 ft., From ft. to ft.
 From ft. to ft., From ft. to ft.
 GRAVEL PACK INTERVALS: From 33 ft. to 15 ft., From ft. to ft.
 From ft. to ft., From ft. to ft.

6 GROUT MATERIAL: 1 Neat cement 2 Cement grout 3 Bentonite 4 Other Bentonite 15'-8.9'
 Grout Intervals: From 8.9 ft. to 3 ft., From ft. to Concrete ft., From 3 ft. to 8 ft.

What is the nearest source of possible contamination: 10 Livestock pens 14 Abandoned water well
 1 Septic tank 4 Lateral lines 7 Pit privy 11 Fuel storage 15 Oil well/Gas well
 2 Sewer lines 5 Cess pool 8 Sewage lagoon 12 Fertilizer storage 16 Other (specify below)
 3 Watertight sewer lines 6 Seepage pit 9 Feedyard 13 Insecticide storage UST Site

Direction from well? How many feet?

FROM	TO	LITHOLOGIC LOG	FROM	TO	PLUGGING INTERVALS
0	4	Dark Brown Silty Clay			
4	9	Brown Fine Sand and Silt			
9	12	Brown Silt and Fine Sand			
12	23	Brown Silt and Fine Sand			
23	30	Brown Fine to Medium Sand			
30	<u>32</u>	Brown / Gray Fine to Coarse Sand			
* Location referenced to Ft. Riley Datum					
281,096 N 2,358,739 E 1056.5 Elev.					

7 CONTRACTOR'S OR LANDOWNER'S CERTIFICATION: This water well was (1) constructed, (2) reconstructed, or (3) plugged under my jurisdiction and was completed on (mo/day/year) 12/15/94 and this record is true to the best of my knowledge and belief. Kansas Water Well Contractor's License No. 510 This Water Well Record was completed on (mo/day/yr) 2/20/95 under the business name of MIKON Corporation by (signature) Daniel Keamer