

1 LOCATION OF WATER WELL: County: Greene Fraction \* SW 1/4 See Below SW 1/4 Section Number 28 Township Number T 11 S Range Number R 6 E/W

Distance and direction from nearest town or city street address of well if located within city?

On 4th St., One Block N. of L Street Camp Funston, Ft. Riley, KS 1245 MW 94-5

2 WATER WELL OWNER: U.S. Army Corps of Engineers


RR#, St. Address, Box # : 601 East 12th St.

Board of Agriculture, Division of Water Resource

City, State, ZIP Code : Kansas City, MO 64106

Application Number:

3 LOCATE WELL'S LOCATION WITH AN "X" IN SECTION BOX:

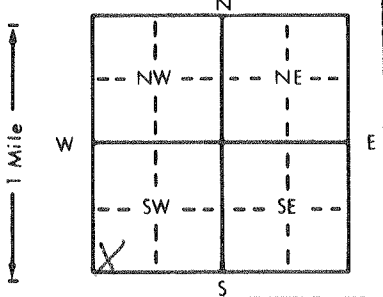

4 DEPTH OF COMPLETED WELL: 25.5 ft. ELEVATION: .....

Depth(s) Groundwater Encountered 1. 18.3 ft. 2. .... ft. 3. .... ft.

WELL'S STATIC WATER LEVEL 183 ft. below land surface measured on mo/day/yr 11/17/94

Pump test data: Well water was ..... ft. after ..... hours pumping ..... gpm

Est. Yield ..... gpm: Well water was ..... ft. after ..... hours pumping ..... gpm

Bore Hole Diameter: 10.5 in. to 26 ft., and ..... in. to ..... ft.

WELL WATER TO BE USED AS: 5 Public water supply 8 Air conditioning 11 Injection well

1 Domestic 3 Feedlot 6 Oil field water supply 9 Dewatering 12 Other (Specify below)

2 Irrigation 4 Industrial 7 Lawn and garden only 10 Monitoring well

Was a chemical/bacteriological sample submitted to Department? Yes No; If yes, mo/day/yr sample was submitted

Water Well Disinfected? Yes No

5 TYPE OF BLANK CASING USED:

1 Steel 3 RMP (SR) 5 Wrought iron 8 Concrete tile CASING JOINTS: Glued ..... Clamped .....

2 PVC 4 ABS 6 Asbestos-Cement 9 Other (specify below) Welded .....

Blank casing diameter 2 in. to 10 ft., Dia ..... in. to ..... ft., Dia ..... in. to ..... ft.

Casing height above land surface: 36 in., weight 6"x6" Steel Cover lbs./ft. Wall thickness or gauge No. Sch 40

TYPE OF SCREEN OR PERFORATION MATERIAL:

1 Steel 3 Stainless steel 5 Fiberglass 7 PVC 10 Asbestos-cement

2 Brass 4 Galvanized steel 6 Concrete tile 8 RMP (SR) 11 Other (specify) .....

SCREEN OR PERFORATION OPENINGS ARE: 5 Gauzed wrapped 8 Saw cut 11 None (open hole)

1 Continuous slot 3 Mill slot 6 Wire wrapped 9 Drilled holes

2 Louvered shutter 4 Key punched 7 Torch cut 10 Other (specify) .....

SCREEN-PERFORATED INTERVALS: From 25 ft. to 10 ft., From ..... ft. to ..... ft.

From ..... ft. to ..... ft., From ..... ft. to ..... ft.

GRAVEL PACK INTERVALS: From 26 ft. to 8 ft., From ..... ft. to ..... ft.

From ..... ft. to ..... ft., From ..... ft. to ..... ft.

6 GROUT MATERIAL: 1 Neat cement 2 Cement grout 3 Bentonite 4 Other Bentonite to 5'

Grout Intervals: From 5 ft. to 3 ft., From ..... ft. to Concrete ft., From 3 ft. to 0 ft.

What is the nearest source of possible contamination:

1 Septic tank 4 Lateral lines 7 Pit privy 10 Livestock pens 14 Abandoned water well

2 Sewer lines 5 Cess pool 8 Sewage lagoon 11 Fuel storage 15 Oil well/Gas well

3 Watertight sewer lines 6 Seepage pit 9 Feedyard 12 Fertilizer storage 16 Other (specify below)

Direction from well? How many feet? UST Site

| FROM                                     | TO | LITHOLOGIC LOG            | FROM | TO | PLUGGING INTERVALS |
|--|----|---------------------------|------|----|--------------------|
| 0  | 8  | Brown Silt with Sand      |      |    |                    |
| 8  | 23 | Brown Fine Sand           |      |    |                    |
| 23                                       | 26 | Brown Fine to Coarse Sand |      |    |                    |
| * Location referenced to Ft. Riley Datum |    |                           |      |    |                    |
| 283,512 N.                               |    |                           |      |    |                    |
| 2,363,684 E.                             |    |                           |      |    |                    |
| 1,050.0 Elev.                            |    |                           |      |    |                    |

7 CONTRACTOR'S OR LANDOWNER'S CERTIFICATION: This water well was (1) constructed, (2) reconstructed, or (3) plugged under my jurisdiction and was completed on (mo/day/year) 11/17/94 and this record is true to the best of my knowledge and belief. Kansas

Water Well Contractor's License No. 510 This Water Well Record was completed on (mo/day/yr) 2/17/95

under the business name of MIKON Corporation by (signature) David J. Kramer