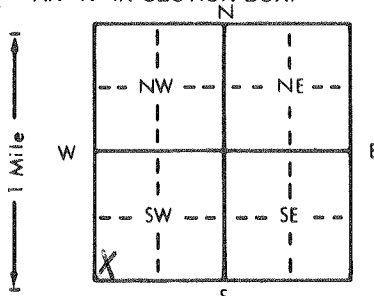


1 LOCATION OF WATER WELL: County: <u>Geary</u>	Fraction: <u>See Below</u> <u>SW 1/4</u> <u>30</u> <u>1/4</u> <u>SW</u> <u>1/4</u>	Section Number <u>28</u>	Township Number T <u>17</u> S	Range Number R <u>6</u> E
---	---	-----------------------------	----------------------------------	------------------------------

Distance and direction from nearest town or city street address of well if located within city?

Just N of B St., Between 8th & 9th St. Camp Funston, Ft. Riley, KS 1890 MW94-1

2 WATER WELL OWNER: U.S. Army Corps of Engineers RR#, St. Address, Box # : 601 East 12th St. City, State, ZIP Code : Kansas City, MO 64106	Board of Agriculture, Division of Water Resource Application Number:
--	---

3 LOCATE WELL'S LOCATION WITH AN "X" IN SECTION BOX: 	4 DEPTH OF COMPLETED WELL: 28.9 ft. ELEVATION: Depth(s) Groundwater Encountered 1. ft. 2. ft. 3. ft. WELL'S STATIC WATER LEVEL 20.2 ft. below land surface measured on mo/day/yr 12/2/94 Pump test data: Well water was ft. after hours pumping gpm Est. Yield gpm: Well water was ft. after hours pumping gpm Bore Hole Diameter 10.5 in. to 30 in. and in. to ft. WELL WATER TO BE USED AS: 5 Public water supply 8 Air conditioning 11 Injection well 1 Domestic 3 Feedlot 6 Oil field water supply 9 Dewatering 12 Other (Specify below) 2 Irrigation 4 Industrial 7 Lawn and garden only 10 Monitoring well Was a chemical/bacteriological sample submitted to Department? Yes No; If yes, mo/day/yr sample was submitted Water Well Disinfected? Yes No
--	---

5 TYPE OF BLANK CASING USED: 1 Steel 3 RMP (SR) 2 PVC 4 ABS Blank casing diameter 2 in. to 13.3 ft. Dia in. to ft. Dia in. to ft. Casing height above land surface 3 in., weight Flush Mount Cover lbs./ft. Wall thickness or gauge No. Sch 40 TYPE OF SCREEN OR PERFORATION MATERIAL: 1 Steel 3 Stainless steel 5 Fiberglass 8 RMP (SR) 2 Brass 4 Galvanized steel 6 Concrete tile 9 ABS 10 Asbestos-cement 11 Other (specify) 12 None used (open hole) SCREEN OR PERFORATION OPENINGS ARE: 1 Continuous slot 3 Mill slot 5 Gauzed wrapped 8 Saw cut 11 None (open hole) 2 Louvered shutter 4 Key punched 6 Wire wrapped 9 Drilled holes 7 Torch cut 10 Other (specify) SCREEN-PERFORATED INTERVALS: From 28.3 ft. to 13.3 ft. From ft. to ft. From ft. to ft. From ft. to ft. GRAVEL PACK INTERVALS: From 30 ft. to 11.5 ft. From ft. to ft. From ft. to ft. From ft. to ft.	CASING JOINTS: Glued Clamped Welded Threaded X
--	--

6 GROUT MATERIAL: 1 Neat cement 2 Cement grout 3 Bentonite 4 Other Bentonite 11.5' to 7' Grout Intervals: From 7 ft. to 4 ft. From ft. to Concrete ft. From 4 ft. to 0 ft. What is the nearest source of possible contamination: 1 Septic tank 4 Lateral lines 7 Pit privy 10 Livestock pens 14 Abandoned water well 2 Sewer lines 5 Cess pool 8 Sewage lagoon 11 Fuel storage 15 Oil well/Gas well 3 Watertight sewer lines 6 Seepage pit 9 Feedyard 12 Fertilizer storage 16 Other (specify below) UST Site Direction from well? How many feet?
--

FROM	TO	LITHOLOGIC LOG	FROM	TO	PLUGGING INTERVALS
0	2'	Crushed Stone			
2'	3'	Brown Clay			
3'	6'	Brown Silt			
6'	10'	Fine Brown Sand			
10'	30'	Brown Fine to Coarse Sand			
		* Location referenced to Ft. Riley Datum			
		278,942 N.			
		2,359,295 E.			
		1051.8 Elev.			

7 CONTRACTOR'S OR LANDOWNER'S CERTIFICATION: This water well was (1) constructed, (2) reconstructed, or (3) plugged under my jurisdiction and was completed on (mo/day/year) 12/2/94 and this record is true to the best of my knowledge and belief. Kansas Water Well Contractor's License No. 510 This Water Well Record was completed on (mo/day/yr) 2/20/95 under the business name of MIKON Corporation by (signature) <u>David Kramm</u>
--