


1 LOCATION OF WATER WELL: Fraction **See Below* Section Number *28* Township Number *T 11 S* Range Number *R 6* E/W
 County: *Geary* Distance and direction from nearest town or city street address of well if located within city?

One Block East of Pershing Ave. on Dickman Ave., Ft. Riley, Kansas 388MW94-2

2 WATER WELL OWNER: *U.S. Army Corps of Engineers*
 RR#, St. Address, Box #: *601 East 12th St.* Board of Agriculture, Division of Water Resources
 City, State, ZIP Code: *Kansas City, Missouri 64106* Application Number:

3 LOCATE WELL'S LOCATION WITH AN "X" IN SECTION BOX:

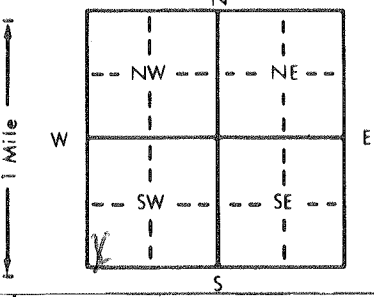

4 DEPTH OF COMPLETED WELL: *41.5* ft. ELEVATION:
 Depth(s) Groundwater Encountered 1. *34* ft. 2. ft. 3. ft.
 WELL'S STATIC WATER LEVEL ft. below land surface measured on mo/day/yr *11/29/94*
 Pump test data: Well water was ft. after hours pumping gpm
 Est. Yield gpm: Well water was ft. after hours pumping gpm
 Bore Hole Diameter: *10.5* in. to *42* ft., and in. to ft.
 WELL WATER TO BE USED AS: 5 Public water supply 8 Air conditioning 11 Injection well
 1 Domestic 3 Feedlot 6 Oil field water supply 9 Dewatering 12 Other (Specify below)
 2 Irrigation 4 Industrial 7 Lawn and garden only 10 Monitoring well
 Was a chemical/bacteriological sample submitted to Department? Yes..... No; If yes, mo/day/yr sample was submitted
 Water Well Disinfected? Yes No

5 TYPE OF BLANK CASING USED: 5 Wrought iron 8 Concrete tile CASING JOINTS: Glued Clamped
 1 Steel 3 RMP (SR) 6 Asbestos-Cement 9 Other (specify below) Welded ~~.....~~
2 PVC 4 ABS 7 Fiberglass Threaded X

Blank casing diameter *2* in. to *26* ft., Dia in. to ft., Dia in. to ft.
 Casing height above land surface: *3* in., weight *Flush-Mount Cover* lbs./ft. Wall thickness or gauge No. *Sch 40*

TYPE OF SCREEN OR PERFORATION MATERIAL: 7 PVC 10 Asbestos-cement
 1 Steel 3 Stainless steel 5 Fiberglass 8 RMP (SR) 11 Other (specify)
 2 Brass 4 Galvanized steel 6 Concrete tile 9 ABS 12 None used (open hole)

SCREEN OR PERFORATION OPENINGS ARE: 5 Gauzed wrapped 8 Saw cut 11 None (open hole)
 1 Continuous slot 3 Mill slot 6 Wire wrapped 9 Drilled holes
 2 Louvered shutter 4 Key punched 7 Torch cut 10 Other (specify)

SCREEN-PERFORATED INTERVALS: From *41* ft. to *26* ft., From ft. to ft.
 From ft. to ft., From ft. to ft.
 GRAVEL PACK INTERVALS: From *42* ft. to *24* ft., From ft. to ft.
 From ft. to ft., From ft. to ft.

6 GROUT MATERIAL: 1 Neat cement 2 Cement grout 3 Bentonite 4 Other *Bentonite 24' - 10.2'*
 Grout Intervals: From *10.2'* ft. to *3.5'* ft., From ft. to *Concrete* ft., From *3.5'* ft. to *0* ft.

What is the nearest source of possible contamination:
 1 Septic tank 4 Lateral lines 7 Pit privy 10 Livestock pens 14 Abandoned water well
 2 Sewer lines 5 Cess pool 8 Sewage lagoon 11 Fuel storage 15 Oil well/Gas well
 3 Watertight sewer lines 6 Seepage pit 9 Feedyard 12 Fertilizer storage 16 Other (specify below)
 13 Insecticide storage *UST Site*

Direction from well? How many feet?

FROM	TO	LITHOLOGIC LOG	FROM	TO	PLUGGING INTERVALS
0	32	Brown Fine Sand			
32	37	Brown Clay			
37	42	Brown Fine Sand			
* Location referenced to Ft. Riley Datum 269,392 N. 2,348,362 E. 1,104.5 Elev.					

7 CONTRACTOR'S OR LANDOWNER'S CERTIFICATION: This water well was 1 constructed, (2) reconstructed, or (3) plugged under my jurisdiction and was completed on (mo/day/year) *11/30/94* and this record is true to the best of my knowledge and belief. Kansas Water Well Contractor's License No. *510* This Water Well Record was completed on (mo/day/yr) *2/17/95* under the business name of *MIKON Corporation* by (signature) *David J. Kramer*