


1 LOCATION OF WATER WELL: County: Greene Fraction: *See Below Section Number: 28 Township, Number: T 11 S Range, Number: R 6 E/W

Distance and direction from nearest town or city street address of well if located within city?
 One Block East of Pershing Ave. on Dickman Ave., Ft. Riley, Kansas 388MW94-3

2 WATER WELL OWNER: U.S. Army Corps of Engineers
 RR#, St. Address, Box #: 601 East 12th St.
 City, State, ZIP Code: Kansas City, MO 64106
 Board of Agriculture, Division of Water Resources
 Application Number:

3 LOCATE WELL'S LOCATION WITH AN "X" IN SECTION BOX:

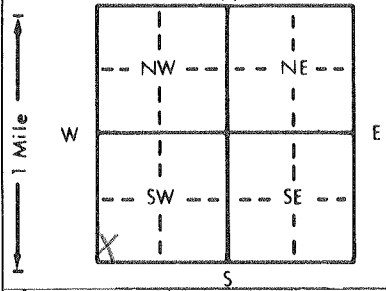

4 DEPTH OF COMPLETED WELL: 39.0 ft. ELEVATION:ft.
 Depth(s) Groundwater Encountered: 1. 34.0 ft. 2.ft. 3.ft.
 WELL'S STATIC WATER LEVEL:ft. below land surface measured on mo/day/yr 11/28/94
 Pump test data: Well water wasft. after hours pumping gpm
 Est. Yield gpm: Well water wasft. after hours pumping gpm
 Bore Hole Diameter: 10.5 in. to 39.2 ft., andin. toft.
 WELL WATER TO BE USED AS:
 5 Public water supply 8 Air conditioning 11 Injection well
 1 Domestic 3 Feedlot 6 Oil field water supply 9 Dewatering 12 Other (Specify below)
 2 Irrigation 4 Industrial 7 Lawn and garden only 10 Monitoring well
 Was a chemical/bacteriological sample submitted to Department? Yes.....No.....; If yes, mo/day/yr sample was submitted
 Water Well Disinfected? Yes No

5 TYPE OF BLANK CASING USED:
 1 Steel 3 RMP (SR) 5 Wrought iron 8 Concrete tile CASING JOINTS: Glued Clamped
2 PVC 4 ABS 6 Asbestos-Cement 9 Other (specify below) Welded
 7 Fiberglass Threaded: X

Blank casing diameter: 2 in. to 23 ft., Diain. toft., Diain. toft.
 Casing height above land surface: 3 in., weight Flush Mount Cover lbs./ft. Wall thickness or gauge No. Sch 40

TYPE OF SCREEN OR PERFORATION MATERIAL:
 1 Steel 3 Stainless steel 5 Fiberglass 7 PVC 10 Asbestos-cement
 2 Brass 4 Galvanized steel 6 Concrete tile 8 RMP (SR) 11 Other (specify)
 9 ABS 12 None used (open hole)

SCREEN OR PERFORATION OPENINGS ARE:
 1 Continuous slot 3 Mill slot 5 Gauzed wrapped 8 Saw cut 11 None (open hole)
 2 Louvered shutter 4 Key punched 6 Wire wrapped 9 Drilled holes
 7 Torch cut 10 Other (specify)

SCREEN-PERFORATED INTERVALS: From 38 ft. to 23 ft., Fromft. toft.
 Fromft. toft., Fromft. toft.
 GRAVEL PACK INTERVALS: From 39.2 ft. to 21 ft., Fromft. toft.
 Fromft. toft., Fromft. toft.

6 GROUT MATERIAL: 1 Neat cement 2 Cement grout 3 Bentonite 4 Other Bentonite 21' to 11'
 Grout Intervals: From 11 ft. to 35 ft., Fromft. to Concrete ft., From 3.5 ft. to 0 ft.

What is the nearest source of possible contamination:
 1 Septic tank 4 Lateral lines 7 Pit privy 10 Livestock pens 14 Abandoned water well
 2 Sewer lines 5 Cess pool 8 Sewage lagoon 11 Fuel storage 15 Oil well/Gas well
 3 Watertight sewer lines 6 Seepage pit 9 Feedyard 12 Fertilizer storage 16 Other (specify below)
 UST Site

Direction from well? How many feet?

FROM	TO	LITHOLOGIC LOG	FROM	TO	PLUGGING INTERVALS
0	8"	Brown Silty Clay			
8"	39'	Brown Sand			
39'	39.2'	Weathered Limestone			
* Location referenced to Ft. Riley Datum 269,065 N. 2,348,517 E. 1,102.0 Elev.					

7 CONTRACTOR'S OR LANDOWNER'S CERTIFICATION: This water well was (1) constructed, (2) reconstructed, or (3) plugged under my jurisdiction and was completed on (mo/day/year) 11/28/94 and this record is true to the best of my knowledge and belief. Kansas Water Well Contractor's License No. 510 This Water Well Record was completed on (mo/day/yr) 2/17/95 under the business name of MIKON Corporation by (signature) David J. Kramer