


1 LOCATION OF WATER WELL: County: Geary Fraction: \* See Below SW 1/4 SW 1/4 SW 1/4 Section Number: 28 Township Number: T 11 S Range Number: R 6 E/W

Distance and direction from nearest town or city street address of well if located within city?

On 4th St., One Block N. of L Street Camp Funston, Ft. Riley, KS 1245 MW 94-6

2 WATER WELL OWNER: U.S. Army Corps of Engineers  
 RR#, St. Address, Box #: 601 East 12th St. Board of Agriculture, Division of Water Resources  
 City, State, ZIP Code: Kansas City, MO 64106 Application Number:

3 LOCATE WELL'S LOCATION WITH AN "X" IN SECTION BOX:

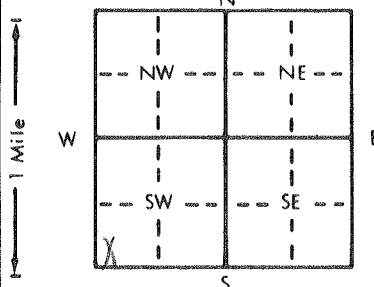

4 DEPTH OF COMPLETED WELL: 25 ft. ELEVATION: .....  
 Depth(s) Groundwater Encountered 1. 18.3 ft. 2. .... ft. 3. .... ft.  
 WELL'S STATIC WATER LEVEL ..... ft. below land surface measured on mo/day/yr 12/8/94  
 Pump test data: Well water was ..... ft. after ..... hours pumping ..... gpm  
 Est. Yield ..... gpm: Well water was ..... ft. after ..... hours pumping ..... gpm  
 Bore Hole Diameter: 10.5 in. to 28 ft., and ..... in. to ..... ft.  
 WELL WATER TO BE USED AS: 5 Public water supply 8 Air conditioning 11 Injection well  
 1 Domestic 3 Feedlot 6 Oil field water supply 9 Dewatering 12 Other (Specify below)  
 2 Irrigation 4 Industrial 7 Lawn and garden only 10 Monitoring well  
 Was a chemical/bacteriological sample submitted to Department? Yes..... No.....; If yes, mo/day/yr sample was submitted  
 Water Well Disinfected? Yes No

5 TYPE OF BLANK CASING USED: 1 Steel 2 PVC 3 RMP (SR) 4 ABS 5 Wrought iron 6 Asbestos-Cement 7 Fiberglass 8 Concrete tile 9 Other (specify below) CASING JOINTS: Glued ..... Clamped ..... Welded ..... Threaded X  
 Blank casing diameter 2 in. to 9.5 ft., Dia ..... in. to ..... ft., Dia ..... in. to ..... ft.  
 Casing height above land surface 36 in., weight 6"x6" Steel Cover lbs./ft. Wall thickness or gauge No. Sch 40  
 TYPE OF SCREEN OR PERFORATION MATERIAL: 1 Steel 2 Brass 3 Stainless steel 4 Galvanized steel 5 Fiberglass 6 Concrete tile 7 PVC 8 RMP (SR) 9 ABS 10 Asbestos-cement 11 Other (specify) ..... 12 None used (open hole)  
 SCREEN OR PERFORATION OPENINGS ARE: 1 Continuous slot 2 Louvered shutter 3 Mill slot 4 Key punched 5 Gauzed wrapped 6 Wire wrapped 7 Torch cut 8 Saw cut 9 Drilled holes 10 Other (specify) ..... 11 None (open hole)  
 SCREEN-PERFORATED INTERVALS: From 24.5 ft. to 9.5 ft., From ..... ft. to ..... ft.  
 GRAVEL PACK INTERVALS: From 28 ft. to 7.5 ft., From ..... ft. to ..... ft.

6 GROUT MATERIAL: 1 Neat cement 2 Cement grout 3 Bentonite 4 Other Bentonite 7.5' - 5.5'  
 Grout Intervals: From 5.5 ft. to 3 ft., From ..... ft. to Concrete ft., From 3 ft. to 0 ft.  
 What is the nearest source of possible contamination:  
 1 Septic tank 2 Sewer lines 3 Watertight sewer lines 4 Lateral lines 5 Cess pool 6 Seepage pit 7 Pit privy 8 Sewage lagoon 9 Feedyard 10 Livestock pens 11 Fuel storage 12 Fertilizer storage 13 Insecticide storage 14 Abandoned water well 15 Oil well/Gas well 16 Other (specify below) UST Site

Direction from well? How many feet?

FROM	TO	LITHOLOGIC LOG	FROM	TO	PLUGGING INTERVALS
0	17.5	Brown Silty Clay to Clayey Silt			
17.5	19	Brown Fine Sand			
19	21	Gray Sandy Silt			
21	28	Gray Fine to Medium Sand			
		* Location referenced to Ft. Riley Datum			
		283,446 N.			
		2,363,364 E.			
		1,047.7 Elev.			

7 CONTRACTOR'S OR LANDOWNER'S CERTIFICATION: This water well was 1 constructed, (2) reconstructed, or (3) plugged under my jurisdiction and was completed on (mo/day/year) 12/8/94 and this record is true to the best of my knowledge and belief. Kansas Water Well Contractor's License No. 510 This Water Well Record was completed on (mo/day/yr) 2/17/95 under the business name of MIKON Corporation by (signature) David J. Kramer