

1 LOCATION OF WATER WELL: Fraction * See Below SW 1/4 SW 1/4 SW 1/4 Section Number 28 Township Number T 11 S Range Number R 6 E
 County: Greene


Distance and direction from nearest town or city street address of well if located within city?

One Block East of Pershing Ave. on Dickman Ave., Ft. Riley, Kansas

388 MW5-94

2 WATER WELL OWNER: U.S. Army Corps of Engineers
 RR#, St. Address, Box # : 601 East 12th Board of Agriculture, Division of Water Resources
 City, State, ZIP Code : Kansas City, Missouri 64106 Application Number:

3 LOCATE WELL'S LOCATION WITH AN "X" IN SECTION BOX:

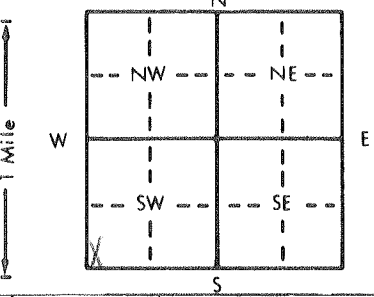

4 DEPTH OF COMPLETED WELL: 32.7 ft. ELEVATION:ft.
 Depth(s) Groundwater Encountered 1. 25 ft. 2.ft. 3.ft.
 WELL'S STATIC WATER LEVELft. below land surface measured on mo/day/yr 11/30/94
 Pump test data: Well water wasft. after hours pumping gpm
 Est. Yield gpm: Well water wasft. after hours pumping gpm
 Bore Hole Diameter: 10.5 in. to 33.2 ft., and in. toft.
 WELL WATER TO BE USED AS: 5 Public water supply 8 Air conditioning 11 Injection well
 1 Domestic 3 Feedlot 6 Oil field water supply 9 Dewatering 12 Other (Specify below)
 2 Irrigation 4 Industrial 7 Lawn and garden only 10 Monitoring well
 Was a chemical/bacteriological sample submitted to Department? Yes.....No.....; If yes, mo/day/yr sample was submitted
 Water Well Disinfected? Yes No

5 TYPE OF BLANK CASING USED: 5 Wrought iron 8 Concrete tile CASING JOINTS: Glued Clamped
 1 Steel 3 RMP (SR) 6 Asbestos-Cement 9 Other (specify below) Welded
2 PVC 4 ABS 7 Fiberglass Threaded. X
 Blank casing diameter 2 in. to 17 ft., Dia in. toft., Dia in. toft.
 Casing height above land surface: 3 in., weight Flush Mount Cover lbs./ft. Wall thickness or gauge No. Sch 40
 TYPE OF SCREEN OR PERFORATION MATERIAL: 7 PVC 10 Asbestos-cement
 1 Steel 3 Stainless steel 5 Fiberglass 8 RMP (SR) 11 Other (specify)
 2 Brass 4 Galvanized steel 6 Concrete tile 9 ABS 12 None used (open hole)
 SCREEN OR PERFORATION OPENINGS ARE: 5 Gauzed wrapped 8 Saw cut 11 None (open hole)
 1 Continuous slot 3 Mill slot 6 Wire wrapped 9 Drilled holes
 2 Louvered shutter 4 Key punched 7 Torch cut 10 Other (specify)
 SCREEN-PERFORATED INTERVALS: From 32 ft. to 17 ft., Fromft. toft.
 Fromft. toft., Fromft. toft.
 GRAVEL PACK INTERVALS: From 33.2 ft. to 15 ft., Fromft. toft.
 Fromft. toft., Fromft. toft.

6 GROUT MATERIAL: 1 Neat cement 2 Cement grout 3 Bentonite 4 Other Bentonite 15' - 9.5'
 Grout Intervals: From 9.5 ft. to 3.5 ft., Fromft. to Concrete ft., From 3.5 ft. to 0 ft.
 What is the nearest source of possible contamination:
 1 Septic tank 4 Lateral lines 7 Pit privy 10 Livestock pens 14 Abandoned water well
 2 Sewer lines 5 Cess pool 8 Sewage lagoon 11 Fuel storage 15 Oil well/Gas well
 3 Watertight sewer lines 6 Seepage pit 9 Feedyard 12 Fertilizer storage 16 Other (specify below)
 UST Site
 Direction from well? How many feet?

FROM	TO	LITHOLOGIC LOG	FROM	TO	PLUGGING INTERVALS
0	20	Fine Brown sand			
20	26	Brown Silty Sand			
26	33.2	Brown Fine to Medium Sand			
* Location referenced to Ft. Riley Datum					
269,355 N.					
2,348,612 E.					
1,094.3 Elev.					

7 CONTRACTOR'S OR LANDOWNER'S CERTIFICATION: This water well was (1) constructed, (2) reconstructed, or (3) plugged under my jurisdiction and was completed on (mo/day/year) 11/30/95 and this record is true to the best of my knowledge and belief. Kansas Water Well Contractor's License No. 510. This Water Well Record was completed on (mo/day/yr) 2/17/95 under the business name of MIKON Corporation by (signature) David J. Kramer