

WATER WELL PLUGGING RECORD Form WWC-5P

KSA 82a-1212

ID NO.

MW5


1 LOCATION OF WATER WELL: County: RILEY	Fraction SW ¼ SW¼ NW ¼ ¼	Section Number 1	Township Number T 11 S	Range Number 7 <input checked="" type="checkbox"/> E <input type="checkbox"/> W
---	-----------------------------	---------------------	---------------------------	--

Street/Rural Address of Well Location; if unknown, distance & direction from nearest town or intersection: If at owner's address, check here 2850 WEST 32ND AVE
MANHATTAN, KS 66502

Global Positioning Systems (GPS) information:
Latitude: _____ (in decimal degrees)
Longitude: _____ (in decimal degrees)
Elevation: 1035.24
Horizontal Datum: WGS84, NAD83, NAD27
Collection Method:

2 WATER WELL OWNER: KANSAS STATE UNIVERSITY
RR#, St. Address, Box #: 108 EDWARDS HALL
City, State ZIP Code: MANHATTAN, KS 66505

GPS unit (Make/Model: _____)
 Digital Map/Photo, Topographic Map, Land Survey
Est. Accuracy: < 3 m, 3-5 m, 5-15 m, > 15 m

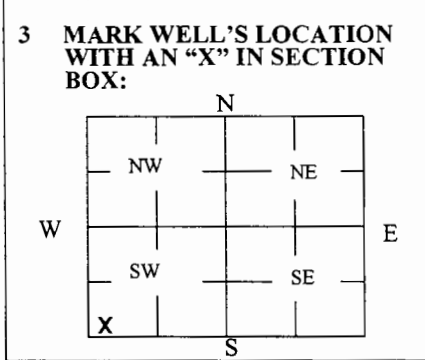

4 DEPTH OF WELL 29.83 ft.
WELL'S STATIC WATER LEVEL 22.86 ft
WELL WAS USED AS:
 Domestic Irrigation Feedlot Industrial
 Public Water Supply Oil Field Water Supply Domestic (Lawn & Garden) Air Conditioning
 Dewatering Monitoring Injection Well Other _____
Was a chemical/bacteriological sample submitted to Department? Yes No

5 TYPE OF BLANK CASING USED:
 Steel PVC RMP (SR) ABS Wrought Asbestos-Cement Fiberglass Concrete Tile Other (Specify below) _____
Blank casing diameter 2 in. Was casing pulled? Yes No If yes, how much 3'
Casing height above or below land surface 0 in.

6 GROUT PLUG MATERIAL: Neat cement Cement grout Bentonite Other SOIL 0-0.5
Grout Plug Intervals: From 0.5 ft. to 29.83 ft., From _____ ft. to _____ ft., From _____ ft. to _____ ft.
What is the nearest source of possible contamination:
 Septic tank Sewer lines Watertight sewer lines Lateral lines Cess pool
 Seepage pit Pit privy Sewage lagoon Feedyard Livestock pens
 Fuel storage Fertilizer storage Insecticide storage Abandoned water well Oil well/Gas well
 Other (specify below) _____
Direction from well? _____
How many feet? _____


FROM	TO	PLUGGING MATERIALS	FROM	TO	PLUGGING MATERIALS
0	0.5	SOIL			
0.5	29.83	BENTONITE			
					KDHE #
					US-081-14444

7 CONTRACTOR'S OR LANDOWNER'S CERTIFICATION: This water well was plugged under my jurisdiction and was completed on (mo/day/year) 12/15/22 and this record is true to the best of my knowledge and belief. Kansas Water Well Contractor's License No. 585. This Water Well Record was completed on (mo/day/year) 12/20/22 under the business name of ASSOCIATED ENVIRONMENTAL INC. by (signature) *[Signature]*


Send one white copy to Kansas Department of Health & Environment, Geology Section, 1000 SW Jackson Street, Ste. 420, Topeka, KS 66612-1367. Send one copy to WATER WELL OWNER and retain one for your records.
Visit us at <http://www.kdheks.gov/waterwell/index.html> Telephone 785-296-5524.

Kiley



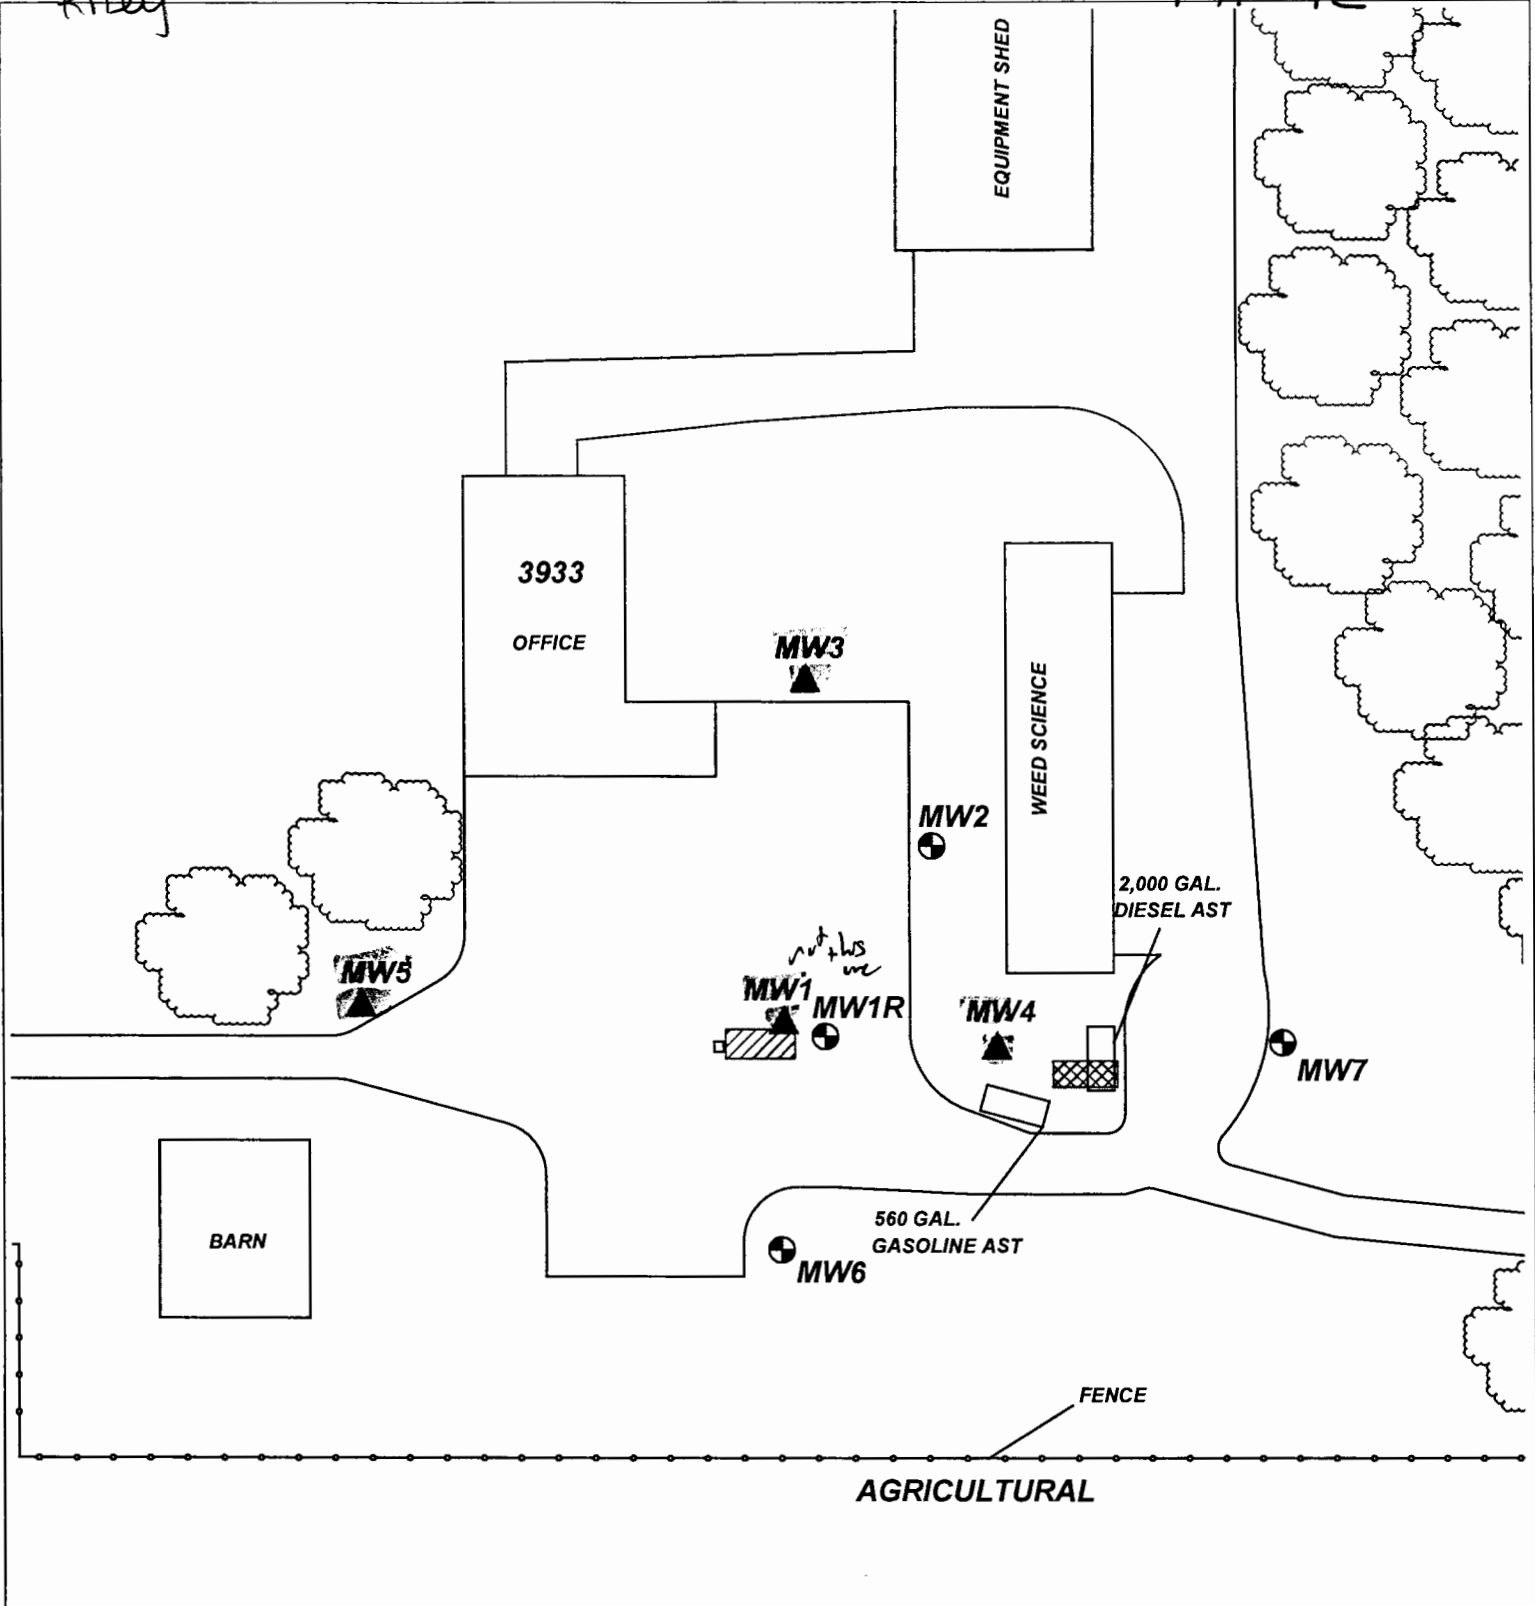



1-11-7E




PROJECT: KSU - ASHLAND BOTTOMS
ADDRESS: 2850 W. 32ND AVE.
LOCATION: MANHATTAN, KS
DRAWN BY: B. SCOTT **DATE:** 4/04/13
REVISED BY: B. STALNAKER **DATE:** 12/20/22
AEI JOB #: TF447 **KDHE JOB #:** U5-081-14444

TITLE:
 **ASSOCIATED ENVIRONMENTAL INC.**

LEGEND:

-  = FORMER 1,000 GAL. GASOLINE UST
-  = FORMER 1,000 GAL. DIESEL UST
-  = MONITOR WELL
-  = DOMESTIC WELL
-  = SITE PROPERTY BOUNDARY
-  = PLUGGED MONITOR WELL

SCALE: 1" = 50'

 0 25 50

NOTES: SAMPLING DATE: 1/31/18