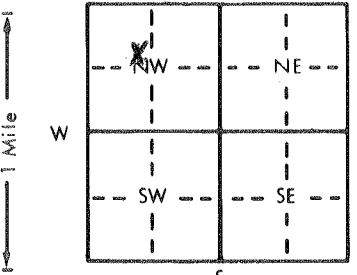


1] LOCATION OF WATER WELL: Fraction SE 1/4 NW 1/4 NW 1/4 Section Number 4 Township Number T 11 S Range Number R 7 E XX  
 County: Riley

Distance and direction from nearest town or city street address of well if located within city?  
3 mi. W of W edge of Manhattan, KS on K18-1/2 S-1/4 W-1/8 S

2] WATER WELL OWNER: Albert D. Wood - Wood & Wood Farms, Inc.  
 RR#, St. Address, Box #: Rt. 1, Box 316 Board of Agriculture, Division of Water Resources  
 City, State, ZIP Code: Manhattan, KS 66502 Application Number: 36,750

3] LOCATE WELL'S LOCATION WITH AN "X" IN SECTION BOX:  4] DEPTH OF COMPLETED WELL: 58 ft. ELEVATION: XXXXX  
 Depth(s) Groundwater Encountered 1. 18 ft. 2. 18 ft. 3. 18 ft.  
 WELL'S STATIC WATER LEVEL 18 ft. below land surface measured on mo/day/yr XXXXX  
 Pump test data: Well water was 26 ft. after 1 hours pumping 800 gpm  
 Est. Yield 1,200 gpm: Well water was 31 ft. after 2 hours pumping 800 gpm  
 Bore Hole Diameter 32 in. to 58 ft., and     in. to     ft.  
 WELL WATER TO BE USED AS: 5 Public water supply 8 Air conditioning 11 Injection well  
 1 Domestic 3 Feedlot 6 Oil field water supply 9 Dewatering 12 Other (Specify below)  
 2 Irrigation 4 Industrial 7 Lawn and garden only 10 Observation well  
 Was a chemical/bacteriological sample submitted to Department? Yes     No X; If yes, mo/day/yr sample was submitted      
 Water Well Disinfected? Yes     No X

5] TYPE OF BLANK CASING USED: 5 Wrought iron 8 Concrete tile CASING JOINTS: Glued     Clamped X  
 1 Steel 3 RMP (SR) 6 Asbestos-Cement 9 Other (specify below) Welded      
 2 PVC 4 ABS 7 Fiberglass     Threaded    

Blank casing diameter 16 in. to 32 ft., Dia     in. to     ft., Dia     in. to     ft.  
 Casing height above land surface 12 in., weight 38 lbs./ft. Wall thickness or gauge No. 75

TYPE OF SCREEN OR PERFORATION MATERIAL: 7 PVC 10 Asbestos-cement  
 1 Steel 3 Stainless steel 5 Fiberglass 8 RMP (SR) 11 Other (specify)      
 2 Brass 4 Galvanized steel 6 Concrete tile 9 ABS 12 None used (open hole)

SCREEN OR PERFORATION OPENINGS ARE: 5 Gauzed wrapped 8 Saw cut 11 None (open hole)  
 1 Continuous slot 3 Mill slot 6 Wire wrapped 9 Drilled holes  
 2 Louvered shutter 4 Key punched 7 Torch cut 10 Other (specify)    

SCREEN-PERFORATED INTERVALS: From 31 ft. to 58 ft., From     ft. to     ft.  
 From     ft. to     ft., From     ft. to     ft.  
 GRAVEL PACK INTERVALS: From 10 ft. to 58 ft., From     ft. to     ft.  
 From     ft. to     ft., From     ft. to     ft.

6] GROUT MATERIAL: 1 Neat cement 2 Cement grout 3 Bentonite 4 Other      
 Grout Intervals: From 0 ft. to 10 ft., From     ft. to     ft., From     ft. to     ft.

What is the nearest source of possible contamination: 10 Livestock pens 14 Abandoned water well  
 1 Septic tank 4 Lateral lines 7 Pit privy 11 Fuel storage 15 Oil well/Gas well  
 2 Sewer lines 5 Cess pool 8 Sewage lagoon 12 Fertilizer storage 16 Other (specify below)  
 3 Watertight sewer lines 6 Seepage pit 9 Feedyard 13 Insecticide storage

Direction from well? NE How many feet? 250 ft.

FROM	TO	LITHOLOGIC LOG	FROM	TO	LITHOLOGIC LOG
0	1	Sandy Silt			
1	9	Fine brown sand			
9	13	Soft brown silt			
13	17	Fine brown sand			
17	19	Sml-Med. brown gravel			
19	21	Small brown sand			
21	23	Med.-lrg gray gravel and gray clay			
23	57	Med.-lrg. gray gravel (clear)			
57	58	Hard green shale STOPPED			

7] CONTRACTOR'S OR LANDOWNER'S CERTIFICATION: This water well was (1) constructed, (2) reconstructed, or (3) plugged under my jurisdiction and was completed on (mo/day/year) 9-7-83 and this record is true to the best of my knowledge and belief. Kansas Water Well Contractor's License No. 323 This Water Well Record was completed on (mo/day/yr) 10-5-83 under the business name of Hoobler Drilling Company by (signature) [Signature]

INSTRUCTIONS: Use typewriter or ball point pen, PLEASE PRESS FIRMLY and PRINT clearly. Please fill in blanks, underline or circle the correct answers. Send top three copies to Kansas Department of Health and Environment, Division of Environment, Environmental Geology Section, Topeka, KS 66620. Send one to WATER WELL OWNER and retain one for your records.