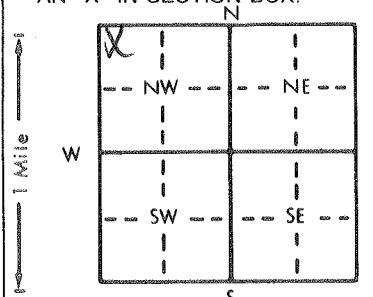


1 LOCATION OF WATER WELL: County: <u>Riley</u>	Fraction <u>NN 1/4 NN 1/4 NW 1/4</u>	Section Number <u>18</u>	Township Number T <u>11</u> S	Range Number R <u>7</u> <u>EW</u>
---	---	-----------------------------	----------------------------------	--------------------------------------

Distance and direction from nearest town or city street address of well if located within city?

S.E. FUNSTON LAND FILLMW2

2 WATER WELL OWNER: <u>U.S. Army</u> RR#, St. Address, Box # : <u>DEH</u> City, State, ZIP Code : <u>7th Riley Ks 66442</u>	Board of Agriculture, Division of Water Resources Application Number:
---	--

3 LOCATE WELL'S LOCATION WITH AN "X" IN SECTION BOX: 	4 DEPTH OF COMPLETED WELL: <u>17.5</u> ft. ELEVATION: Depth(s) Groundwater Encountered 1. ft. 2. ft. 3. ft. WELL'S STATIC WATER LEVEL ... <u>10</u> ... ft. below land surface measured on mo/day/yr Pump test data: Well water was ft. after hours pumping gpm Est. Yield gpm: Well water was ft. after hours pumping gpm Bore Hole Diameter ... <u>2</u> ... in. to ... <u>TD</u> ... ft., and ... in. to ... ft. WELL WATER TO BE USED AS: 5 Public water supply 8 Air conditioning 11 Injection well 1 Domestic 3 Feedlot 6 Oil field water supply 9 Dewatering 12 Other (Specify below) 2 Irrigation 4 Industrial 7 Lawn and garden only <u>10</u> Monitoring well Was a chemical/bacteriological sample submitted to Department? Yes No <u>✓</u> ; If yes, mo/day/yr sample was submitted Water Well Disinfected? Yes No <u>✓</u>
--	---

5 TYPE OF BLANK CASING USED: 1 Steel 2 PVC Blank casing diameter ... <u>2</u> ... in. to ... <u>7.5</u> ... ft., Dia ... in. to ... ft., Dia ... in. to ... ft. Casing height above land surface ... <u>30</u> ... in., weight ... lbs./ft. Wall thickness or gauge No. TYPE OF SCREEN OR PERFORATION MATERIAL: 1 Steel 3 Stainless steel 5 Fiberglass 8 RMP (SR) 2 Brass 4 Galvanized steel 6 Concrete tile 9 ABS SCREEN OR PERFORATION OPENINGS ARE: 1 Continuous slot 3 Mill slot 5 Gauzed wrapped 8 Saw cut 11 None (open hole) 2 Louvered shutter 4 Key punched 6 Wire wrapped 9 Drilled holes 10 Other (specify) SCREEN-PERFORATED INTERVALS: From ... <u>7.5</u> ... ft. to ... <u>17.5</u> ... ft., From ... ft. to ... ft., From ... ft. to ... ft. GRAVEL PACK INTERVALS: From ... <u>N/A</u> ... ft. to ... ft., From ... ft. to ... ft., From ... ft. to ... ft.	CASING JOINTS: Glued Clamped Welded <u>✓</u> Threaded <u>✓</u>
--	--

6 GROUT MATERIAL: 1 Neat cement 2 Cement grout 3 Bentonite 4 Other Grout Intervals: From ... <u>0</u> ... ft. to ... <u>5</u> ... ft., From ... ft. to ... ft., From ... ft. to ... ft. What is the nearest source of possible contamination: 1 Septic tank 4 Lateral lines 7 Pit privy 10 Livestock pens 14 Abandoned water well 2 Sewer lines 5 Cess pool 8 Sewage lagoon 11 Fuel storage 15 Oil well/Gas well 3 Watertight sewer lines 6 Seepage pit 9 Feedyard 12 Fertilizer storage 16 Other (specify below) 13 Insecticide storage <u>LAND FILL</u> Direction from well? <u>WITHIN</u> How many feet? <u>WITHIN</u>
--

FROM	TO	LITHOLOGIC LOG	FROM	TO	PLUGGING INTERVALS
<u>0</u>	<u>TD</u>	<u>SILTY SAND</u>			
		<u>NOTE: DRIVE PT</u>			

7 CONTRACTOR'S OR LANDOWNER'S CERTIFICATION: This water well was (1) constructed, (2) reconstructed, or (3) plugged under my jurisdiction and was completed on (mo/day/year) ... <u>8/19/94</u> ... and this record is true to the best of my knowledge and belief. Kansas Water Well Contractor's License No. ... <u>102-581</u> ... This Water Well Record was completed on (mo/day/yr) ... <u>8/19/94</u> ... under the business name of <u>Layne</u> <u>Wichita</u> by (signature) <u>[Signature]</u>
