

# WATER WELL PLUGGING RECORD Form WWC-5P

KSA 82a-1212

ID NO.

Barr Well


<b>1 LOCATION OF WATER WELL:</b> Riley County	Fraction NE ¼ NE ¼ NW ¼	Section Number 1	Township Number 11 S	Range Number R 8 E
--	----------------------------	---------------------	-------------------------	-----------------------

Distance and direction from nearest town or city street address of well if located within city?

Well was located at Pilsbury Circle Rd.

<b>2 WATER WELL OWNER:</b> Roger L. Barr RR#, St. Address, Box #: 19 Ridgecrest Rd. City, State ZIP Code: Stamford, CT. 06903	<b>Global Positioning Systems</b> (decimal degrees, min. of 4 digits) Latitude: _____ Longitude: _____ Elevation: _____ Datum: _____ Data Collection Method: _____
--	---

**3 MARK WELL'S LOCATION WITH AN "X" IN SECTION BOX:**

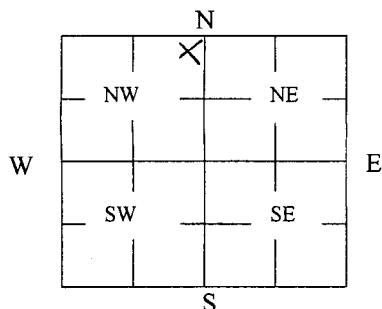

**4 DEPTH OF WELL** 52.00 ft.

WELL'S STATIC WATER LEVEL 30.00 ft

WELL WAS USED AS:

- |   |                            |                   |
|---|----------------------------|-------------------|
| <input checked="" type="radio"/> Domestic | 5 Public Water Supply      | 9 Dewatering      |
| 2 Irrigation                              | 6 Oil Field Water Supply   | 10 Monitoring     |
| 3 Feedlot                                 | 7 Domestic (Lawn & Garden) | 11 Injection Well |
| 4 Industrial                              | 8 Air Conditioning         | 12 Other _____    |

Was a chemical/bacteriological sample submitted to Department? Yes \_\_\_\_\_ No x \_\_\_\_\_

**5 TYPE OF BLANK CASING USED:**

- |  |            |                   |                 |                               |
|--|------------|-------------------|-----------------|-------------------------------|
| <input checked="" type="radio"/> Steel | 3 RMP (SR) | 5 Wrought         | 7 Fiberglass    | 9 Other (Specify below) _____ |
| 2 PVC                                  | 4 ABS      | 6 Asbestos-Cement | 8 Concrete Tile |                               |

Blank casing diameter 2 in. Was casing pulled? Yes \_\_\_\_\_ No X \_\_\_\_\_ If yes, how much \_\_\_\_\_

Casing height above or below land surface 36" Below surface \_\_\_\_\_ in.

**6 GROUT PLUG MATERIAL:** 1 Neat cement 2 Cement grout 3 Bentonite 4 Other Chlorinated Sand

Grout Plug Intervals: 3 From 0 ft. to 30 ft., 4 From 30 ft. to 52 ft., From \_\_\_\_\_ to \_\_\_\_\_ ft.

What is the nearest source of possible contamination:

- |                          |   |                         |                                   |
|--------------------------|---|-------------------------|-----------------------------------|
| 1 Septic tank            | 6 Seepage pit                                   | 11 Fuel Storage         | 16 Other (specify below) _____    |
| 2 Sewer lines            | 7 Pit privy                                     | 12 Fertilizer storage   |                                   |
| 3 Watertight sewer lines | 8 Sewage lagoon                                 | 13 Insecticide storage  |                                   |
| 4 Lateral lines          | 9 Feedyard                                      | 14 Abandoned water well | Direction from well? <u>North</u> |
| 5 Cess pool              | <input checked="" type="radio"/> Livestock pens | 15 Oil well/Gas well    | How many feet? <u>100'</u>        |

FROM	TO	PLUGGING MATERIALS	FROM	TO	PLUGGING MATERIALS
0'	30'	Bentonite Chips			
30'	52'	Chlorinated Sand			
0	12'	Soil between casing and hand dug well, upper 3' of rocks removed			

**7 CONTRACTOR'S OR LANDOWNER'S CERTIFICATION:** This water well was plugged under my jurisdiction and was completed on (mo/day/year) 2/25/2010 and this record is true to the best of my knowledge and belief. Kansas Water Well Contractor's License No. 585. This Water Well Record was completed on (mo/day/year) 3/2/2010 under the business name of Associated Environmental, Inc. by (signature) [Signature]

**INSTRUCTIONS:** Use typewriter or ballpoint pen. Please press firmly and print clearly. Please fill in blanks, underline or circle the correct answers. Send top three copies to Kansas Department of Health and Environment, Bureau of Water, Geology Section, 1000 SW Jackson St., Ste. 420, Topeka, Kansas 66612-1367. Telephone: 785/296-5522. Send one to Water Well Owner and retain one for your records. Visit us at <http://www.kdheks.gov/waterwell/index.html>