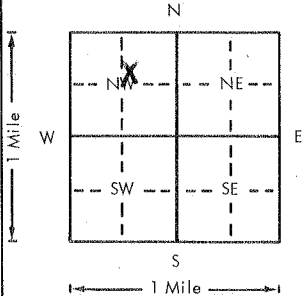


USE TYPEWRITER OR BALL  
POINT PEN-PRESS FIRMLY,  
PRINT CLEARLY.

WATER WELL RECORD  
KSA 82a-1201-1215

Kansas Department of Health and  
Environment-Division of Environment  
(Water well Contractors)  
Topeka, Kansas 66620

1. Location of well:	County <b>RILEY</b>	Fraction <b>SW 1/4 NE 1/4 NW 1/4</b>	Section number <b>1</b>	Township number T <b>11</b> S	Range number R <b>8</b> E
2. Distance and direction from nearest town or city:	<b>5 miles S.E. from</b>		3. Owner of well: <b>LEWIS FAHEY</b>		
Street address of well location if in city:	<b>MANHATTAN, KS.</b>		R.R. or street: <b>RR 5</b>		
			City, state, zip code: <b>MANHATTAN, KS. 66502</b>		
4. Locate with "X" in section below: Sketch map: 			6. Bore hole dia. <b>8</b> in. Completion date <b>11-25-81</b> Well depth <b>80</b> ft.		
			7. <input checked="" type="checkbox"/> Cable tool <input type="checkbox"/> Rotary <input type="checkbox"/> Driven <input type="checkbox"/> Dug <input type="checkbox"/> Hollow rod <input type="checkbox"/> Jetted <input type="checkbox"/> Bored <input type="checkbox"/> Reverse rotary		
			8. Use: <input checked="" type="checkbox"/> Domestic <input type="checkbox"/> Public supply <input type="checkbox"/> Industry <input type="checkbox"/> Irrigation <input type="checkbox"/> Air conditioning <input type="checkbox"/> Stock <input type="checkbox"/> Lawn <input type="checkbox"/> Oil field water <input type="checkbox"/> Other		
			9. Casing: Material <b>STEEL</b> Height: Above or below Threaded <input type="checkbox"/> Welded <input checked="" type="checkbox"/> Surface <b>22</b> in. RMP <input type="checkbox"/> PVC <input type="checkbox"/> Weight <b>21</b> lbs./ft. Dia. <b>8</b> in. to <b>80</b> ft. depth Wall Thickness: inches or Dia. <input type="checkbox"/> in. to <input type="checkbox"/> ft. depth gage No. <b>14"</b>		
5. Type and color of material			From	To	10. Screen: Manufacturer's name
<b>Top Soil</b>			<b>0</b>	<b>20</b>	Type <b>SLOT</b> Dia. <b>8"</b>
<b>Soft Blue Mud</b>			<b>20</b>	<b>60</b>	Slot/gauze <b>.125</b> Length <b>10'</b>
<b>Yellow Rock</b>			<b>60</b>	<b>64</b>	Set between <b>60</b> ft. and <b>70</b> ft.
<b>Blue Shale</b>			<b>64</b>	<b>80</b>	ft. and <input type="checkbox"/> ft.
					Gravel pack? <input checked="" type="checkbox"/> Size range of material <b>PEA</b>
					11. Static water level: <input type="checkbox"/> mo./day/yr. <b>57</b> ft. below land surface Date <b>11-25-81</b>
					12. Pumping level below land surfaces: ft. after <input type="checkbox"/> hrs. pumping <input type="checkbox"/> g.p.m. ft. after <input type="checkbox"/> hrs. pumping <input type="checkbox"/> g.p.m. Estimated maximum yield <b>12</b> g.p.m.
					13. Water sample submitted: <input type="checkbox"/> mo./day/yr. <input type="checkbox"/> Yes <input checked="" type="checkbox"/> No Date
					14. Well head completion: <b>CAP</b> <input type="checkbox"/> Pitless adapter <b>22</b> inches above grade
					15. Well grouted? <input checked="" type="checkbox"/> With: <input checked="" type="checkbox"/> Neat cement <input type="checkbox"/> Bentonite <input type="checkbox"/> Concrete Depth: From <b>1</b> ft. to <b>10</b> ft.
					16. Nearest source of possible contamination: <b>NONE</b> ft. <input type="checkbox"/> Direction <input type="checkbox"/> Type <input type="checkbox"/> Well disinfected upon completion? <input type="checkbox"/> Yes <input type="checkbox"/> No
					17. Pump: <input checked="" type="checkbox"/> Not installed Manufacturer's name <input type="checkbox"/> Model number <input type="checkbox"/> HP <input type="checkbox"/> Volts <input type="checkbox"/> Length of drop pipe <input type="checkbox"/> ft. capacity <input type="checkbox"/> g.p.m. Type: <input type="checkbox"/> Submersible <input type="checkbox"/> Turbine <input type="checkbox"/> Jet <input type="checkbox"/> Reciprocating <input type="checkbox"/> Centrifugal <input type="checkbox"/> Other
(Use a second sheet if needed)					
18. Elevation:	19. Remarks:		20. Water well contractor's certification: This well was drilled under my jurisdiction and this report is true to the best of my knowledge and belief. <b>RAY E. ENSLEY Well Drilling 202</b> Business name License No. Address <b>2010 MANHATTAN, KS 66502</b> Signed <b>[Signature]</b> Date <b>11-25-81</b> Authorized representative		
Topography: <input type="checkbox"/> Hill <input type="checkbox"/> Slope <input type="checkbox"/> Upland <input checked="" type="checkbox"/> Valley					

Forward the white, blue and pink copies to the Department of Health and Environment

Form WWC-5