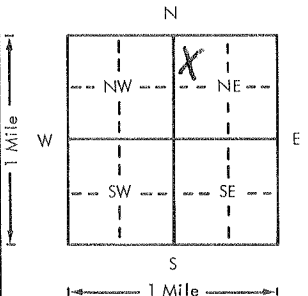
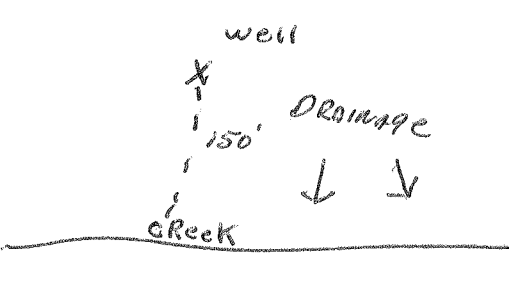


USE TYPEWRITER OR BALL
POINT PEN-PRESS FIRMLY,
PRINT CLEARLY.

WATER WELL RECORD
KSA 82a-1201-1215

To BUS 10-13-78
BWS 11-28-79
9

Kansas Department of Health and
Environment-Division of Environment
(Water well Contractors)
Topeka, Kansas 66620

1. Location of well:		County Riley	Fraction NW 1/4 NW 1/4 NE 1/4	Section number 3	Township number T 11 0	Range number R 8 9 0
2. Distance and direction from nearest town or city: 35 1.6 E		3. Owner of well: ROGER KUASNIKA R.R. or street: RT. 3 City, state, zip code: MANHATTAN, KS 66502				
4. Locate with "X" in section below: 		Sketch map: 		6. Bore hole dia. 8 in. Completion date 9-18-78 Well depth 100 ft.		
5. Type and color of material		From	To	7. <input checked="" type="checkbox"/> Cable tool <input checked="" type="checkbox"/> Rotary <input type="checkbox"/> Driven <input type="checkbox"/> Dug <input type="checkbox"/> Hollow rod <input type="checkbox"/> Jetted <input type="checkbox"/> Bored <input type="checkbox"/> Reverse rotary		
Top Soil		0	4	8. Use: <input checked="" type="checkbox"/> Domestic <input checked="" type="checkbox"/> Public supply <input type="checkbox"/> Industry <input type="checkbox"/> Stock <input type="checkbox"/> Other		
Clay, Brown		4	21	9. Casing: Material PVC Height: 60 or below		
Shale, yellow		21	30	Threading: <input type="checkbox"/> Welded <input type="checkbox"/> Surface 48 in.		
Limestone, yellow, loose		30	33	RMP: <input type="checkbox"/> PVC <input checked="" type="checkbox"/> Weight 2.58 lbs./ft.		
Shale Limestone, grey		33	80	Dia. 5 in. to 100 ft. depth Wall Thickness: inches or		
Shale, grey		80	100	Dia. 5 in. to 100 ft. depth gage No. 279		
				10. Screen: Manufacturer's name Pumpco MPE		
				Type PVC Dia. 5		
				Slot/gauge .020 Length 20		
				Set between 25 ft. and 45 ft.		
				Gravel pack? <input checked="" type="checkbox"/> Size range of material 30/60		
				11. Static water level: 20 ft. below land surface Date 9-18-78		
				12. Pumping level below land surfaces: ____ ft. after ____ hrs. pumping ____ g.p.m. ____ ft. after ____ hrs. pumping ____ g.p.m. Estimated maximum yield 30 g.p.m.		
				13. Water sample submitted: <input checked="" type="checkbox"/> Yes <input type="checkbox"/> No Date 9-18-78		
				14. Well head completion: cap ____ Pitless adapter 48 inches above grade		
				15. Well grouted? <input checked="" type="checkbox"/> With: <input checked="" type="checkbox"/> Neat cement <input type="checkbox"/> Bentonite <input type="checkbox"/> Concrete Depth: From 0 ft. to 20 ft.		
				16. Nearest source of possible contamination: ft. 150 Direction S Type Creek Well disinfected upon completion? <input checked="" type="checkbox"/> Yes <input type="checkbox"/> No		
				17. Pump: <input checked="" type="checkbox"/> Not installed Manufacturer's name _____ Model number _____ HP _____ Volts _____ Length of drop pipe _____ ft. capacity _____ g.p.m. Type: ____ Submersible _____ Turbine ____ Jet _____ Reciprocating ____ Centrifugal _____ Other		
18. Elevation:		19. Remarks:		20. Water well contractor's certification: This well was drilled under my jurisdiction and this report is true to the best of my knowledge and belief. STRADER DRUG CO 182 Business name License No. Address RT 1 Holton, KS Signed Dee Ashen Date 9-22-78 Authorized representative		