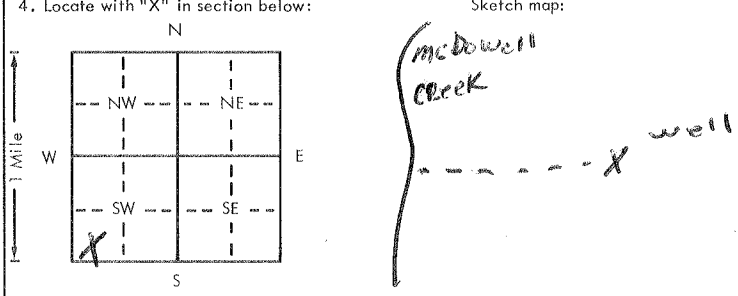


USE TYPEWRITER OR BALL
POINT PEN-PRESS FIRMLY,
PRINT CLEARLY.

WATER WELL RECORD
KSA 82a-1201-1215

Kansas Department of Health and
Environment-Division of Environment
(Water well Contractors)
Topeka, Kansas 66620

1. Location of well:	County Riley	Fraction SW 1/4 SW 1/4 SW 1/4	Section number 6	Township number T 11 S R 8 E W	Range number
2. Distance and direction from nearest town or city:	4 S of		3. Owner of well: RON BURKE		
Street address of well location if in city: MANHATTAN		R.R. or street: 404 POPULAR PL.		City, state, zip code: MANHATTAN	
4. Locate with "X" in section below:		Sketch map:		6. Bore hole dia. 10 in. Completion date _____ Well depth 75 ft. 6-6-78	
				7. <input checked="" type="checkbox"/> Cable tool <input checked="" type="checkbox"/> Rotary <input type="checkbox"/> Driven <input type="checkbox"/> Dug <input type="checkbox"/> Hollow rod <input type="checkbox"/> Jetted <input type="checkbox"/> Bored <input type="checkbox"/> Reverse rotary	
5. Type and color of material		From	To	8. Use: <input checked="" type="checkbox"/> Domestic <input type="checkbox"/> Public supply <input type="checkbox"/> Industry <input type="checkbox"/> Irrigation <input type="checkbox"/> Air conditioning <input type="checkbox"/> Stock <input type="checkbox"/> Lawn <input type="checkbox"/> Oil field water <input type="checkbox"/> Other	
Top Soil		0	5	9. Casing: Material PVC Height: 60 ft. or below Threaded <input type="checkbox"/> Welded <input type="checkbox"/> Surface 24 in. RMP <input type="checkbox"/> PVC 90 Weight 258 lbs./ft. Dia. 5 in. to 75 ft. depth Wall Thickness: inches or Dia. _____ in. to _____ ft. depth gage No. 1279	
Clay Brown		5	52	10. Screen: Manufacturer's name Pumpco MPF Type PVC Dia. 5 Slot/gauze 1.020 Length 20 Set between 55 ft. and 75 ft. _____ ft. and _____ ft. Gravel pack? <input checked="" type="checkbox"/> Size range of material 10-20	
Chert Gravel		52	72	11. Static water level: _____ mo./day/yr. 50 ft. below land surface Date 6-6-78	
Shale, gray		72	75	12. Pumping level below land surfaces: _____ ft. after _____ hrs. pumping _____ g.p.m. _____ ft. after _____ hrs. pumping _____ g.p.m. Estimated maximum yield 100 g.p.m.	
				13. Water sample submitted: _____ mo./day/yr. Yes <input checked="" type="checkbox"/> No <input type="checkbox"/> Date _____	
				14. Well head completion: CAP Pitless adapter 24 Inches above grade	
				15. Well grouted? <input checked="" type="checkbox"/> With: <input checked="" type="checkbox"/> Neat cement <input type="checkbox"/> Bentonite <input type="checkbox"/> Concrete Depth: From 0 ft. to 10 ft.	
				16. Nearest source of possible contamination: ft. 150 Direction W Type Creek Well disinfected upon completion? <input checked="" type="checkbox"/> Yes <input type="checkbox"/> No	
				17. Pump: <input checked="" type="checkbox"/> Not installed Manufacturer's name _____ Model number _____ HP _____ Volts _____ Length of drop pipe _____ ft. capacity _____ g.p.m. Type: <input type="checkbox"/> Submersible <input type="checkbox"/> Turbine <input type="checkbox"/> Jet <input type="checkbox"/> Reciprocating <input type="checkbox"/> Centrifugal <input type="checkbox"/> Other	
18. Elevation:		19. Remarks:		20. Water well contractor's certification: This well was drilled under my jurisdiction and this report is true to the best of my knowledge and belief. STRADER DRIG CO INC 182 Business name _____ License No. _____ Address RT 1 HOLTEN, KS Signed Dale Ashburn Date 6-8-78 Authorized representative	
Topography: <input type="checkbox"/> Hill <input type="checkbox"/> Slope <input type="checkbox"/> Upland <input checked="" type="checkbox"/> Valley		OWNED TO INSTAL SLOD			

Forward the white, blue and pink copies to the Department of Health and Environment

Form WWC-5