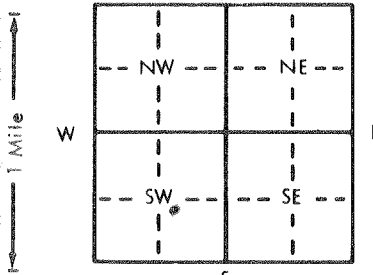


1 LOCATION OF WATER WELL: Fraction NW 1/4 SE 1/4 SW 1/4 Section Number 10 Township Number T 11 S Range Number R 8 EW
 County: RILEY
 Distance and direction from nearest town or city street address of well if located within city?

2 WATER WELL OWNER: LW GUEST
 RR#, St. Address, Box #: 1010 LARAMIE
 City, State, ZIP Code: MANHATTAN, KS. 66502
 Board of Agriculture, Division of Water Resource
 Application Number:

3 LOCATE WELL'S LOCATION WITH AN "X" IN SECTION BOX:

 4 DEPTH OF COMPLETED WELL: 79 ft. ELEVATION: SLOPE
 Depth(s) Groundwater Encountered 1. 12 ft. 2. 32 ft. 3. ft.
 WELL'S STATIC WATER LEVEL 25 ft. below land surface measured on mo/day/yr 8-14-84
 Pump test data: Well water was ft. after hours pumping gpm
 Est. Yield 20 gpm: Well water was ft. after hours pumping gpm
 Bore Hole Diameter 8 in. to 79 ft. and in. to ft.
 WELL WATER TO BE USED AS: 5 Public water supply 8 Air conditioning 11 Injection well
 1 Domestic 3 Feedlot 6 Oil field water supply 9 Dewatering 12 Other (Specify below)
 2 Irrigation 4 Industrial 7 Lawn and garden only 10 Observation well
 Was a chemical/bacteriological sample submitted to Department? Yes No X; If yes, mo/day/yr sample was submitted
 Water Well Disinfected? Yes X No

5 TYPE OF BLANK CASING USED:
 1 Steel 3 RMP (SR) 5 Wrought iron 8 Concrete tile CASING JOINTS: Glued X Clamped
 2 PVC 4 ABS 6 Asbestos-Cement 9 Other (specify below) Welded
 7 Fiberglass Threaded
 Blank casing diameter 5 in. to 79 ft. Dia. in. to ft. Dia. in. to ft.
 Casing height above land surface 26 in., weight 2.82 lbs./ft. Wall thickness or gauge No. 258
 TYPE OF SCREEN OR PERFORATION MATERIAL:
 1 Steel 3 Stainless steel 5 Fiberglass 7 PVC 10 Asbestos-cement
 2 Brass 4 Galvanized steel 6 Concrete tile 8 RMP (SR) 11 Other (specify)
 9 ABS 12 None used (open hole)
 SCREEN OR PERFORATION OPENINGS ARE:
 1 Continuous slot 3 Mill slot 5 Gauzed wrapped 8 Saw cut 11 None (open hole)
 2 Louvered shutter 4 Key punched 6 Wire wrapped 9 Drilled holes
 7 Torch cut 10 Other (specify)
 SCREEN-PERFORATED INTERVALS: From 40 ft. to 50 ft. From 30 ft. to 20 ft.
 From 20 ft. to 50 ft. From 30 ft. to 20 ft.
 GRAVEL PACK INTERVALS: From 10 ft. to 79 ft. From 30 ft. to 20 ft.

6 GROUT MATERIAL: 1 Neat cement 2 Cement grout 3 Bentonite 4 Other
 Grout Intervals: From 3 ft. to 16 ft. From ft. to ft. From ft. to ft.
 What is the nearest source of possible contamination: WATER STARTED AT 12' SEATED OFF
 1 Septic tank 4 Lateral lines 7 Pit privy 10 Livestock pens 14 Abandoned water well
 2 Sewer lines 5 Cess pool 8 Sewage lagoon 11 Fuel storage 15 Oil well/Gas well
 3 Watertight sewer lines 6 Seepage pit 9 Feedyard 12 Fertilizer storage 16 Other (specify below)
 13 Insecticide storage

FROM	TO	LITHOLOGIC LOG	FROM	TO	LITHOLOGIC LOG
0	9	SOIL			
9	11	GRAVEL			
11	16	YELLOW ROCK (LITTLE WATER)			
16	30	GREEN SHALE			
30	33	SOFT YELLOW ROCK (WATER)			
33	42	GREEN SHALE			
42	48	HARD BROWN ROCK			
48	56	GRAY SHALE			
56	60	GRAY ROCK			
60	79	BLUE SHALE			

7 CONTRACTOR'S OR LANDOWNER'S CERTIFICATION: This water well was (1) constructed, (2) reconstructed, or (3) plugged under my jurisdiction and was completed on (mo/day/year) Aug 14, 84 and this record is true to the best of my knowledge and belief. Kansas
 Water Well Contractor's License No. 202 This Water Well Record was completed on (mo/day/yr) Aug 14, 84
 under the business name of ENSLEY WELL DRILLING by (signature) Gray

INSTRUCTIONS: Use typewriter or ball point pen, PLEASE PRESS FIRMLY and PRINT clearly. Please fill in blanks, underline or circle the correct answers. Send to three copies to Kansas Department of Health and Environment, Division of Environment, Environmental Geology Section, Topeka, KS 66620. Send one to WATER WELL OWNER and retain one for your records.