


WW353

1 LOCATION OF WATER WELL: Fraction SE 1/4 NR 1/4 NW 1/4 Section Number 35 Township Number T 11 S Range Number R 9 E
 County: WABAUNSEE

Distance and direction from nearest town or city street address of well if located within city?
From ALMA: 3 MILES NORTH TO I-70, 4.5 MILES WEST, 5/8 SOUTH

2 WATER WELL OWNER: MEL RICHART
 RR#, St. Address, Box # : _____ Board of Agriculture, Division of Water Resources
 City, State, ZIP Code : _____ Application Number: _____

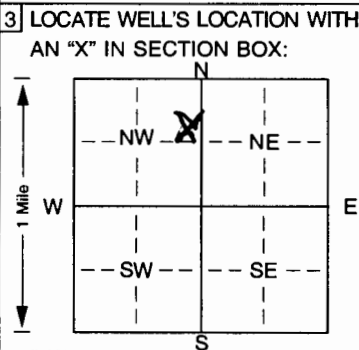

4 DEPTH OF COMPLETED WELL: 242 ft. ELEVATION: _____
 Depth(s) Groundwater Encountered 1. 87 ft. 2. _____ ft. 3. _____ ft.
 WELL'S STATIC WATER LEVEL _____ ft. below land surface measured on mo/day/yr _____
 Pump test data: Well water was _____ ft. after _____ hours pumping _____ gpm
 Est. Yield _____ gpm: Well water was _____ ft. after _____ hours pumping _____ gpm
 Bore Hole Diameter: 5.125 in. to 242 ft., and _____ in. to _____ ft.
 WELL WATER TO BE USED AS: 5 Public water supply 8 Air conditioning 11 Injection well
 1 Domestic 3 Feedlot 6 Oil field water supply 9 Dewatering 12 Other (Specify below)
 2 Irrigation 4 Industrial 7 Domestic (lawn & garden) 10 Monitoring well CLOSED LOOP
 Was a chemical/bacteriological sample submitted to Department? Yes. _____ No. X; If yes, mo/day/yr sample was submitted _____
 Water Well Disinfected? Yes _____ No. X

5 TYPE OF BLANK CASING USED:
 1 Steel 3 RMP (SR) 5 Wrought iron 8 Concrete tile CASING JOINTS: Glued _____ Clamped _____
 2 PVC 4 ABS 6 Asbestos-Cement 9 Other (specify below) Welded X
 7 Fiberglass HOPE Threaded _____
 Blank casing diameter 3/4 in. to 242 ft., Dia _____ in. to _____ ft., Dia _____ in. to _____ ft.
 Casing height below land surface. 48 in., weight _____ lbs./ft. Wall thickness or gauge No. SDR11
 TYPE OF SCREEN OR PERFORATION MATERIAL:
 1 Steel 3 Stainless steel 5 Fiberglass 7 PVC 10 Asbestos-cement
 2 Brass 4 Galvanized steel 6 Concrete tile 8 RMP (SR) 11 Other (specify) _____
 9 ABS 12 None used (open hole)
 SCREEN OR PERFORATION OPENINGS ARE:
 1 Continuous slot 3 Mill slot 5 Gauzed wrapped 8 Saw cut 11 None (open hole)
 2 Louvered shutter 4 Key punched 7 Torch cut 9 Drilled holes 10 Other (specify) _____ ft.
 SCREEN-PERFORATED INTERVALS: From _____ ft. to _____ ft., From _____ ft. to _____ ft.
 From NA ft. to NA ft., From NA ft. to NA ft.
 GRAVEL PACK INTERVALS: From _____ ft. to _____ ft., From _____ ft. to _____ ft.

6 GROUT MATERIAL: 1 Neat cement 2 Cement grout 3 Bentonite 4 Other _____
 Grout Intervals: From 4 ft. to 242 ft., From _____ ft. to _____ ft., From _____ ft. to _____ ft.
 What is the nearest source of possible contamination:
 1 Septic tank 4 Lateral lines 7 Pit privy 10 Livestock pens 14 Abandoned water well
 2 Sewer lines 5 Cess pool 8 Sewage lagoon 11 Fuel storage 15 Oil well/Gas well
 3 Watertight sewer lines 6 Seepage pit 9 Feedyard 12 Fertilizer storage 16 Other (specify below)
NEW CONSTRUCTION
 Direction from well? _____ How many feet? _____

FROM	TO	LITHOLOGIC LOG	FROM	TO	PLUGGING INTERVALS
0	3	LS TAN	137	141	LIMESTONE GRAY
3	30	SHALE	141	148	SHALE, GRAY
30	32	LIMESTONE GRAY	148	154	LIMESTONE, LIGHT GRAY
32	36	SHALE, BROWN	154	196	SHALE, GRAY
36	38	LIMESTONE	196	199	LIMESTONE GRAY
38	41	SHALE GRAY	199	214	SHALE, BROWN
41	44	LIMESTONE GRAY	214	217	LIMESTONE
44	57	SHALE tan to gray	217	242	SHALE, GRAY
57	61	LIMESTONE GRAY		242	TD
61	78	SHALE, GRAY			
78	87	LIMESTONE TAN			1-242
87	115	SHALE, GRAY			1-230
115	119	LIMESTONE			1-217
119	137	SHALE GRAY			

7 CONTRACTOR'S OR LANDOWNER'S CERTIFICATION: This water well was (1) constructed, (2) reconstructed, or (3) plugged under my jurisdiction and was completed on (mo/day/year) 11/5/02 and this record is true to the best of my knowledge and belief. Kansas Water Well Contractor's Licence No. 585 This Water Well Record was completed on (mo/day/yr) 8/2/02 under the business name of AET by (signature) [Signature]