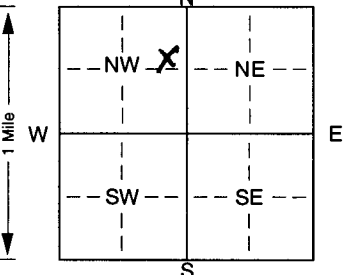


1 LOCATION OF WATER WELL: Fraction SR 1/4 NR 1/4 NW 1/4 Section Number 35 Township Number T 11 S Range Number R 9 EW
 County: ~~WABASH~~ WABAUNSEE

Distance and direction from nearest town or city street address of well if located within city?
From Alma 3.5 miles north to I-70 5 miles west, 3/4 mile south

2 WATER WELL OWNER: NOEL & BOBET RASCHKE
 RR#, St. Address, Box #: 35512 Hendricks Rd Board of Agriculture, Division of Water Resources
 City, State, ZIP Code: ALMA, KS 66401 Application Number: _____

3 LOCATE WELL'S LOCATION WITH AN "X" IN SECTION BOX:

 4 DEPTH OF COMPLETED WELL: 146 ft. ELEVATION: _____ ft.
 Depth(s) Groundwater Encountered: 1. 109 ft. 2. _____ ft. 3. _____ ft.
 WELL'S STATIC WATER LEVEL: 89 ft. below land surface measured on mo/day/yr 6/27/02
 Pump test data: Well water was _____ ft. after _____ hours pumping _____ gpm
 Est. Yield: 3 gpm; Well water was _____ ft. after _____ hours pumping _____ gpm
 Bore Hole Diameter: 8.75 in. to 146 ft., and _____ in. to _____ ft.
 WELL WATER TO BE USED AS:
 1 Domestic (circled) 3 Feedlot 6 Oil field water supply 9 Dewatering 12 Other (Specify below)
 2 Irrigation 4 Industrial 7 Domestic (lawn & garden) 10 Monitoring well
 Was a chemical/bacteriological sample submitted to Department? Yes _____ No _____; If yes, mo/day/yrs sample was submitted _____
 Water Well Disinfected? Yes _____ No _____

5 TYPE OF BLANK CASING USED:
 1 Steel (circled) 3 RMP (SR) 5 Wrought iron 8 Concrete tile CASING JOINTS: Glued (X) Clamped _____
 2 PVC (circled) 4 ABS 6 Asbestos-Cement 9 Other (specify below) Welded _____
 7 Fiberglass Threaded _____
 Blank casing diameter: 5 in. to 86 ft., Dia 5 in. to 136 ft., Dia _____ in. to _____ ft.
 Casing height above land surface: 18 in., weight _____ lbs./ft. Wall thickness or gauge No. 50R26
 TYPE OF SCREEN OR PERFORATION MATERIAL:
 1 Steel 3 Stainless steel 5 Fiberglass 8 RMP (SR) 10 Asbestos-cement
 2 Brass 4 Galvanized steel 6 Concrete tile 9 ABS 11 Other (specify) _____
 12 None used (open hole)
 SCREEN OR PERFORATION OPENINGS ARE:
 1 Continuous slot 3 Mill slot (circled) 5 Gauzed wrapped 8 Saw cut 11 None (open hole)
 2 Louvered shutter 4 Key punched 7 Torch cut 10 Other (specify) _____ ft.
 SCREEN-PERFORATED INTERVALS: From 06 ft. to 96 ft., From _____ ft. to _____ ft.
 From 186 ft. to 146 ft., From _____ ft. to _____ ft.
 GRAVEL PACK INTERVALS: From 24 ft. to 146 ft., From _____ ft. to _____ ft.
 From _____ ft. to _____ ft., From _____ ft. to _____ ft.

6 GROUT MATERIAL: 1 Neat cement 2 Cement grout 3 Bentonite (circled) 4 Other _____
 Grout Intervals: From 0 ft. to 25 ft., From _____ ft. to _____ ft., From _____ ft. to _____ ft.
 What is the nearest source of possible contamination:
 1 Septic tank 4 Lateral lines 7 Pit privy 10 Livestock pens 14 Abandoned water well
 2 Sewer lines 5 Cess pool 8 Sewage lagoon 11 Fuel storage 15 Oil well/Gas well
 3 Watertight sewer lines 6 Seepage pit 9 Feedyard 12 Fertilizer storage 16 Other (specify below) NEW CONSIDER
 13 Insecticide storage
 Direction from well? _____ How many feet? _____

FROM	TO	LITHOLOGIC LOG	FROM	TO	PLUGGING INTERVALS
0	1	Soil			
1	2	Limestone			
2	33	Shale, Tan			
33	40	Limestone, Tan			
40	50	Shale, Gray			
50	51	Limestone			
51	80	Shale, Tan grades to Gray			
80	86	Limestone, Tan			
86	105	Shale, Gray			
105	109	Limestone, Tan			
109	142	Shale, Gray			
142	144	Limestone			
144	146	Shale, Gray			
		TD			

7 CONTRACTOR'S OR LANDOWNER'S CERTIFICATION: This water well was (1) constructed, (2) reconstructed, or (3) plugged under my jurisdiction and was completed on (mo/day/year) 6/27/02 and this record is true to the best of my knowledge and belief. Kansas Water Well Contractor's Licence No. 505 This Water Well Record was completed on (mo/day/yr) 7/26/02 under the business name of ASSOCIATED PUMP & POWER CO. INC by (signature) [Signature]