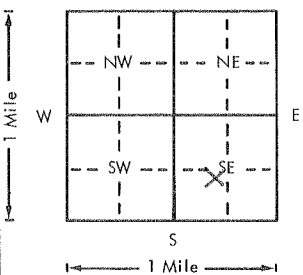


USE TYPEWRITER OR BALL
POINT PEN-PRESS FIRMLY,
PRINT CLEARLY.

WATER WELL RECORD
KSA 82a-1201-1215

Kansas Department of Health and
Environment-Division of Environment
(Water well Contractors)
Topeka, Kansas 66620

1. Location of well:		County <u>Riley</u>	Fraction <u>NE 1/4 SW 1/4 SE 1/4</u>	Section number <u>10</u>	Township number <u>T 11 S</u>	Range number <u>R 9 E</u>
2. Distance and direction from nearest town or city: <u>5 S 2 E</u>		3. Owner of well: <u>Dwayne Talley</u>		R.R. or street: <u>RR 5</u>		
Street address of well location if in city: <u>Zeandale</u>		City, state, zip code: <u>Manhattan, Ks.</u>				
4. Locate with "X" in section below:		Sketch map:		6. Bore hole dia. <u>8 1/2</u> in. Completion date <u>10-10-77</u>		
		<u>Top high hill</u> <u>X well</u> <u>Pasture</u>		Well depth <u>80</u> ft.		
5. Type and color of material		From	To	7. ☒ Cable tool ☒ Rotary ☐ Driven ☐ Dug ☐ Hollow rod ☐ Jetted ☐ Bored ☐ Reverse rotary		
<u>Limestone</u>		<u>0</u>	<u>3</u>	8. Use: ☒ Domestic ☐ Public supply ☐ Industry ☐ Irrigation ☐ Air conditioning ☐ Stock ☐ Lawn ☐ Oil field water ☐ Other		
<u>Tan Shale</u>		<u>3</u>	<u>17</u>	9. Casing: Material <u>PVC</u> Height <u>Above</u> or below Threaded ☐ Welded ☐ Surface <u>24</u> in. RMP <u>PVC Blue</u> Weight <u>2.74</u> lbs./ft. Dia. <u>5</u> in. to <u>80</u> ft. depth Wall Thickness: inches or Dia. <u>5</u> in. to <u>80</u> ft. depth gage No. <u>1258</u>		
<u>Tan Shale L.S.</u>		<u>17</u>	<u>23</u>	10. Screen: Manufacturer's name <u>Flumpe</u> Type <u>Pvc</u> Dia. <u>5"</u> Slot/gauze <u>20</u> Length <u>20'</u> Set between <u>20</u> ft. and <u>40</u> ft. Gravel pack? <u>Yes</u> Size range of material <u>4x1/8</u>		
<u>Gray Shale</u>		<u>23</u>	<u>24</u>	11. Static water level: <u>29</u> ft. below land surface Date <u>10-10-77</u>		
<u>Tan Shale L.S.</u>		<u>24</u>	<u>27</u>	12. Pumping level below land surfaces: <u>Air Test</u> <u>29</u> ft. after <u>0</u> hrs. pumping <u>0</u> g.p.m. <u>29</u> ft. after <u>0</u> hrs. pumping <u>0</u> g.p.m. Estimated maximum yield <u>6</u> g.p.m.		
<u>Orange L.S.</u>		<u>27</u>	<u>30</u>	13. Water sample submitted: <u>0</u> mo./day/yr. ☐ Yes ☒ No Date <u>10-10-77</u>		
<u>Gray Shale</u>		<u>30</u>	<u>41</u>	14. Well head completion: <u>Top Cap</u> ☐ Pitless adapter <u>24</u> inches above grade		
<u>H. Gray Shale L.S.</u>		<u>41</u>	<u>50</u>	15. Well grouted? <u>Yes</u> With: ☒ Neat cement ☐ Bentonite ☐ Concrete Depth: From <u>0</u> ft. to <u>10</u> ft.		
<u>Gray Shale</u>		<u>50</u>	<u>55</u>	16. Nearest source of possible contamination: <u>Note</u> ft. <u>0</u> Direction <u>0</u> Type <u>0</u> Well disinfected upon completion? ☒ Yes ☐ No		
<u>Gray L.S.</u>		<u>55</u>	<u>63</u>	17. Pump: ☒ Not installed Manufacturer's name <u>0</u> Model number <u>0</u> HP <u>0</u> Volts <u>0</u> Length of drop pipe <u>0</u> ft. capacity <u>0</u> g.p.m. Type: ☐ Submersible ☐ Turbine ☐ Jet ☐ Reciprocating ☐ Centrifugal ☐ Other		
<u>H. Gray L.S. Shale</u>		<u>63</u>	<u>71</u>			
<u>Gray Shale</u>		<u>71</u>	<u>80</u>			
(Use a second sheet if needed)						
18. Elevation:	19. Remarks: <u>Owner to pour cement slab</u> <u>#16 well Top high hill in brush & pasture</u>		20. Water well contractor's certification: This well was drilled under my jurisdiction and this report is true to the best of my knowledge and belief. <u>STRADER Dalg Co Inc 182</u> Business name <u>Heiter, Kans</u> License No. <u>0</u> Address <u>0</u> Signed <u>Dale Ashen</u> Date <u>10-11-77</u> Authorized representative			
Topography: ☒ Hill ☐ Slope ☐ Upland ☐ Valley						