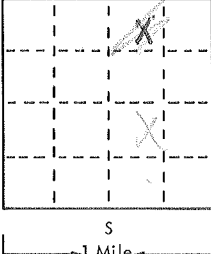
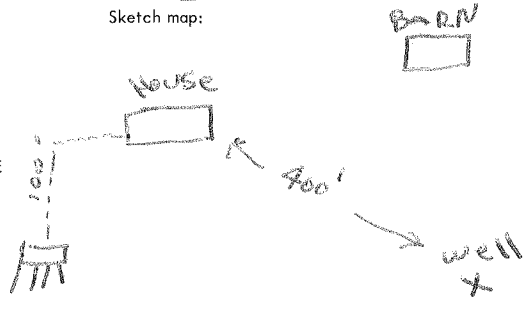


USE TYPEWRITER OR BALL  
POINT PEN-PRESS FIRMLY,  
PRINT CLEARLY.

WATER WELL RECORD  
KSA 82a-1201-1215

T R EW sec 1/4 1/4 1/4 No.

Kansas State Dept. Of Health  
(Water Well Contractors)  
Forbes-Bldg. 740  
Topeka, Kansas 66620

1 Location of well:	County <u>Riley</u>	Township name <u>Andale</u>	Fraction <u>N 1/4 NW 1/4</u>	Section number <u>16</u>	Town number <u>11</u>	Range number <u>9 E</u>
Distance and direction from nearest town or city: <u>65 - 1/2 E</u> <u>2 andale</u>			3 Owner of well: <u>James Smith</u> Address: <u>RR 3 Manhattan Kansas</u>			
Locate with "X" in section below: N 		Sketch map: 		4 Well depth: <u>50</u> ft. Date of completion <u>7-8-75</u> Well diameter <u>8</u> in.		
2 Type and color of material		From		To		
		<u>Top Soil</u>		<u>0 4</u>		
		<u>Yellow Clay</u>		<u>4 19</u>		
		<u>GRAVEL</u>		<u>19 21</u>		
		<u>Grey Limestone</u>		<u>21 28</u>		
<u>Blue Shale</u>		<u>28 50</u>		5 <input type="checkbox"/> Cable tool <input checked="" type="checkbox"/> Rotary <input type="checkbox"/> Driven <input type="checkbox"/> Dug <input type="checkbox"/> Hollow rod <input type="checkbox"/> Jetted <input type="checkbox"/> Bored <input type="checkbox"/> Reverse rotary		
		6 Use: <input checked="" type="checkbox"/> Domestic <input type="checkbox"/> Public supply <input type="checkbox"/> Industry <input type="checkbox"/> Irrigation <input type="checkbox"/> Air conditioning <input type="checkbox"/> Commercial <input type="checkbox"/> Test well <input type="checkbox"/>		7 Casing: Material <u>PVC</u> Height: above/below Threaded <input type="checkbox"/> Welded <input type="checkbox"/> Surface <u>24</u> in. Diam. <u>5</u> in. to <u>50</u> ft. depth Drive shoe? <input type="checkbox"/> Yes <input checked="" type="checkbox"/> No <u>5</u> in. to <u>50</u> ft. depth		
		8 Screen: Manufacturer <u>PumpCo</u> Type <u>PVC</u> Dia. <u>8</u> Slot/gauge <u>.025</u> Length <u>10</u> Set between <u>18</u> ft. and <u>28</u> ft. Fittings: Gravel pack <input checked="" type="checkbox"/> Yes <input type="checkbox"/> No Size range of material <u>#3</u>		9 Static water level: <u>Not measured</u> <u>18</u> ft. below land surface Date <u>7-8-75</u>		
		10 Pumping level below land surfaces: <u>Air Test</u> ____ ft. after ____ hrs. pumping ____ g.p.m. ____ ft. after ____ hrs. pumping ____ g.p.m. Estimated maximum yield <u>2</u> g.p.m.		11 Water sample submitted: <input type="checkbox"/> Yes <input checked="" type="checkbox"/> No Date ____		
		12 Well head completion: <u>Capped</u> <input type="checkbox"/> Pitless adapter <u>24</u> <input checked="" type="checkbox"/> inches above grade		13 Well grouted? <input checked="" type="checkbox"/> Yes <input type="checkbox"/> No <input checked="" type="checkbox"/> Neat cement <input type="checkbox"/> Bentonite <input type="checkbox"/> Depth: From <u>0</u> ft. to <u>10</u> ft.		
		14 Nearest source of possible contamination: ft. <u>125</u> Direction <u>N.W.</u> Type <u>S. Tan</u> Well disinfected upon completion? <input checked="" type="checkbox"/> Yes <input type="checkbox"/> No		15 Pump: <input checked="" type="checkbox"/> Not installed Manufacturer's name ____ Model number ____ HP ____ Volts ____ Length of drop pipe ____ ft. capacity ____ g.p.m. Type: <input type="checkbox"/> Submersible <input type="checkbox"/> Turbine <input type="checkbox"/> Jet <input type="checkbox"/> Reciprocating <input type="checkbox"/> Centrifugal <input type="checkbox"/> Other		
16 Remarks: elevation <u>Owner will install well slab</u> Topography: <u>1190'</u> <input type="checkbox"/> Hill <input type="checkbox"/> Slope <input type="checkbox"/> Upland <input checked="" type="checkbox"/> Valley		17 Water well contractor's certification: This well was drilled under my jurisdiction and this report is true to the best of my knowledge and belief. <u>Strader Drilling Co Inc</u> 182 Business name License No. <u>66426</u> Address <u>RFD 1 Holton KS</u> Signed <u>Dale Peterson</u> Date <u>8-7-75</u> Authorized representative				