


1 LOCATION OF WATER WELL: County: WABAUNSEE Fraction: SE 1/4 SE 1/4 SE 1/4 Section Number: 11 Township Number: T 11 S Range Number: R 9 E

Distance and direction from nearest town or city street address of well if located within city? 1/2 W. 3 S OF WABAUNSEE  
DWAYNE

2 WATER WELL OWNER: CLAUDE TALLEY  
RR#, St. Address, Box #: 200 Research Drive Board of Agriculture, Division of Water Resources  
City, State, ZIP Code: Manhattan, Ks. 66502 Application Number:

3 LOCATE WELL'S LOCATION WITH AN "X" IN SECTION BOX:

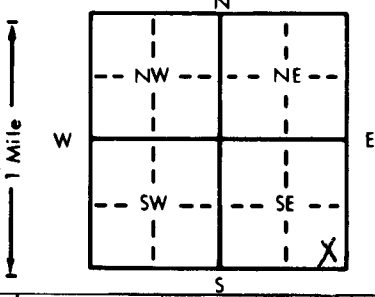

4 DEPTH OF COMPLETED WELL: 80 ft. ELEVATION:

Depth(s) Groundwater Encountered 1. 12 ft. 2. ft. 3. ft.  
WELL'S STATIC WATER LEVEL: 12 ft. below land surface measured on mo/day/yr 9-20-82  
Pump test data: Well water was ft. after hours pumping gpm  
Est. Yield 1 gpm: Well water was ft. after hours pumping gpm  
Bore Hole Diameter: 8 in. to ft., and in. to ft.  
WELL WATER TO BE USED AS:  
5 Public water supply 8 Air conditioning 11 Injection well  
1 Domestic 3 Feedlot 6 Oil field water supply 9 Dewatering 12 Other (Specify below)  
2 Irrigation 4 Industrial 7 Lawn and garden only 10 Observation well  
Was a chemical/bacteriological sample submitted to Department? Yes No; If yes, mo/day/yr sample was submitted  
Water Well Disinfected? Yes No

5 TYPE OF BLANK CASING USED:  
1 Steel 3 RMP (SR) 5 Wrought iron 8 Concrete tile CASING JOINTS: Glued ✓ Clamped  
2 PVC 4 ABS 6 Asbestos-Cement 9 Other (specify below) Welded  
7 Fiberglass Threaded

Blank casing diameter: 5 in. to 0-12 ft., Dia 5 in. to 22-75 ft., Dia in. to ft.  
Casing height above land surface: 24 in., weight 2.82 lbs./ft. Wall thickness or gauge No. 258

TYPE OF SCREEN OR PERFORATION MATERIAL:  
1 Steel 3 Stainless steel 5 Fiberglass 7 PVC 10 Asbestos-cement  
2 Brass 4 Galvanized steel 6 Concrete tile 8 RMP (SR) 11 Other (specify)  
9 ABS 12 None used (open hole)

SCREEN OR PERFORATION OPENINGS ARE:  
1 Continuous slot 3 Mill slot 5 Gauzed wrapped 8 Saw cut 11 None (open hole)  
2 Louvered shutter 4 Key punched 6 Wire wrapped 9 Drilled holes  
7 Torch cut 10 Other (specify)

SCREEN-PERFORATED INTERVALS: From 12 ft. to 22 ft., From ft. to ft.  
From 75 ft. to 80 ft., From ft. to ft.  
GRAVEL PACK INTERVALS: From 10 ft. to 80 ft., From ft. to ft.  
From ft. to ft., From ft. to ft.

6 GROUT MATERIAL: 1 Neat cement 2 Cement grout 3 Bentonite 4 Other  
Grout Intervals: From 0 ft. to 10 ft., From ft. to ft., From ft. to ft.

What is the nearest source of possible contamination:  
1 Septic tank 4 Lateral lines 7 Pit privy 10 Livestock pens 14 Abandoned water well  
2 Sewer lines 5 Cess pool 8 Sewage lagoon 11 Fuel storage 15 Oil well/Gas well  
3 Watertight sewer lines 6 Seepage pit 9 Feedyard 12 Fertilizer storage 16 Other (specify below)  
13 Insecticide storage

Direction from well? E How many feet? 700

FROM	TO	LITHOLOGIC LOG	FROM	TO	LITHOLOGIC LOG
0	3	TOP SOIL			
3	10	CLAY, brown			
10	12	CHERTY LS-brown			
12	24	LIMESTONE, grey			
24	50	SHALE, grey			
50	53	LIMESTONE grey			
53	76	SHALE, grey			
76	78	LIMESTONE grey			
78	80	SHALE, grey			

7 CONTRACTOR'S OR LANDOWNER'S CERTIFICATION: This water well was (1) constructed, (2) reconstructed, or (3) plugged under my jurisdiction and was completed on (mo/day/year) 9-20-82 and this record is true to the best of my knowledge and belief. Kansas

Water Well Contractor's License No. 182 This Water Well Record was completed on (mo/day/yr) 10-19-82  
under the business name of Strader Drlg. Co., Inc by (signature) Dale Asken

INSTRUCTIONS: Use typewriter or ball point pen, PLEASE PRESS FIRMLY and PRINT clearly. Please fill in blanks, underline or circle the correct answers. Send top three copies to Kansas Department of Health and Environment, Division of Environment, Environmental Geology Section, Topeka, KS 66620. Send one to WATER WELL OWNER and retain one for your records.