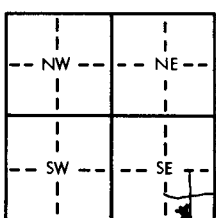
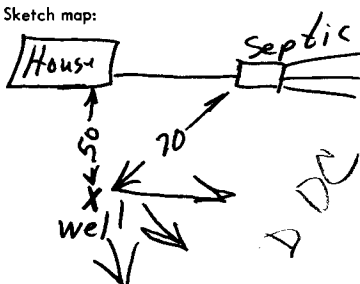


USE TYPEWRITER OR BALL
POINT PEN-PRESS FIRMLY,
PRINT CLEARLY.

WATER WELL RECORD
KSA 82a-1201-1215

Kansas Department of Health and
Environment-Division of Environment
(Water well Contractors)
Topeka, Kansas 66620

1. Location of well: County <u>Dickinson</u> Fraction <u>SW 1/4 SE 1/4 SE 1/4</u> Section number <u>27</u> Township number <u>T 12 S</u> Range number <u>R 1 E</u>		3. Owner of well: <u>Brumblow</u> R.R. or street: <u>RR 4</u> City, state, zip code: <u>Abilene Kan</u>	
2. Distance and direction from nearest town or city: <u>3 mile South and 2 1/4 west of Talmage</u> Street address of well location if in city:		4. Locate with "X" in section below:  Sketch map: 	
5. Type and color of material		6. Bore hole dia. <u>7</u> in. Completion date <u>8-87</u> Well depth <u>50</u> ft.	
Topsoil Sandy Brn		7. <input checked="" type="checkbox"/> Cable tool <input type="checkbox"/> Rotary <input type="checkbox"/> Driven <input type="checkbox"/> Dug <input type="checkbox"/> Hollow rod <input type="checkbox"/> Jetted <input type="checkbox"/> Bored <input type="checkbox"/> Reverse rotary	
Clay & FINE Sand Brn		8. Use: <input checked="" type="checkbox"/> Domestic <input type="checkbox"/> Public supply <input type="checkbox"/> Industry <input type="checkbox"/> Irrigation <input type="checkbox"/> Air conditioning <input type="checkbox"/> Stock <input type="checkbox"/> Lawn <input type="checkbox"/> Oil field water <input type="checkbox"/> Other	
Clay & Coarse Sand Brn		9. Casing: Material <u>PLCS</u> Height <u>Above</u> or below Threaded <input type="checkbox"/> Welded <u>glu</u> Surface <u>14</u> in. RMP <input checked="" type="checkbox"/> PVC <input type="checkbox"/> Weight <input type="checkbox"/> lbs./ft. Dia. <u>5</u> in. to <u>38</u> ft. depth Wall Thickness: inches or Dio. <input type="checkbox"/> in. to <input type="checkbox"/> ft. depth gage No. <u>1200</u>	
Shale - Gray		10. Screen: Manufacturer's name <u>Sunflower</u>	
Shale - Yel		Type <u>RMP</u> Dia. <u>5"</u>	
Shale - Lite		Slot/gauze <u>X6</u> Length <u>12'</u>	
Broken Lime & Shale Conglomerate		Set between <u>38</u> ft. and <u>50</u> ft. ft. and <u>50</u> ft.	
Shale - Lite blue		Gravel pack? <u>Yes</u> Size range of material <u>1/8-3/16</u>	
Broken Lime - Yel		11. Static water level: <u>15</u> ft. below land surface Date <u>8-8-77</u>	
		13. Water sample submitted: <u>X</u> Yes <u>X</u> No Date <u>8-8-77</u>	
		14. Well head completion: <u>14</u> inches above grade	
		15. Well grouted? <u>Yes</u> With: <u>X</u> Neat cement <u>X</u> Bentonite <u>X</u> Concrete Depth: From <u>3</u> ft. to <u>13</u> ft.	
		16. Nearest source of possible contamination: <u>Septic</u> ft. <u>70</u> Direction <u>NE</u> Type <u>Septic</u> Well disinfected upon completion? <u>X</u> Yes <u> </u> No	
		17. Pump: <u>X</u> Not installed Manufacturer's name <u> </u> Model number <u> </u> HP <u> </u> Volts <u> </u> Length of drop pipe <u> </u> ft. capacity <u> </u> g.p.m. Type: <u> </u> Submersible <u> </u> Turbine <u> </u> Jet <u> </u> Reciprocating <u> </u> Centrifugal <u> </u> Other	
18. Elevation:		20. Water well contractor's certification: This well was drilled under my jurisdiction and this report is true to the best of my knowledge and belief. <u>Zinn Water Well Drilling 210</u> Business name <u> </u> License No. <u> </u> Address <u> </u> Signed <u> </u> Date <u>8-9-77</u> Authorized representative	
19. Remarks: <u>Concrete slab to be installed by customer</u> <u>Mrs. Luther Brumblow</u>			

Forward the white, blue and pink copies to the Department of Health and Environment

Form WWC-5