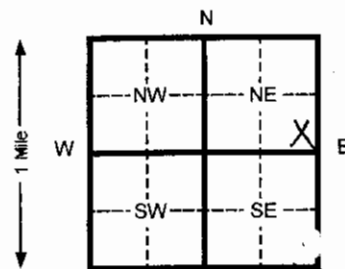


1 LOCATION OF WATER WELL:		Fraction	Section Number		Township Number		Range Number	
County: <b>Dickinson</b>		<b>SE</b> $\frac{1}{4}$ <b>SE</b> $\frac{1}{4}$ <b>NE</b> $\frac{1}{4}$	<b>12</b>		<b>T 12 S</b>		<b>R 1 E</b>	
Distance and direction from nearest town or city street address of well if located within city? <b>Farmers Coop Association, Talmage, Kansas</b>								
2 WATER WELL OWNER: <b>Talmage Cooperative Association</b>								
RR#, St. Address, Box # : <b>2967 Main Street</b> Board of Agriculture, Division of Water Resources								
City, State, ZIP Code : <b>Talmage, Ks 67482</b> Application Number:								
3 LOCATE WELL'S LOCATION WITH AN "X" IN SECTION BOX:			4 DEPTH OF COMPLETED WELL <b>28</b> ft. ELEVATION:					
			Depth(s) Groundwater Encountered 11.5 ft. 2 ft. 3 ft. Ft.					
			WELL'S STATIC WATER LEVEL ft. below land surface measured on mo/day/yr					
			Pump test data: Well water was Ft. after hours pumping Gpm					
			Est. Yield Gpm: Well water was Ft. after Hours pumping Gpm					
Bore Hole Diameter <b>8.625</b> in. to <b>28</b> in. to Ft.			WELL WATER TO BE USED AS: 5 Public water supply 8 Air conditioning 11 Injection well					
1 Domestic 3 Feed lot 6 Oil field water supply 9 Dewatering 12 Other (Specify below)			2 Irrigation 4 Industrial 7 Lawn and garden (domestic) 10 <b>Monitoring well</b> <b>MWT-10</b>					
Was a chemical/bacteriological sample submitted to Department? Yes No <b>X</b> If yes, mo/day/yr sample was Submitted								
Water Well Disinfected? Yes No <b>X</b>								
5 TYPE OF BLANK CASING USED:								
1 Steel 3 RMP (SR)			5 Wrought Iron 8 Concrete tile			CASING JOINTS: Glued Clamped		
2 <b>PVC</b> 4 ABS			6 Asbestos-Cement 9 Other (specify below)			Welded		
			7 Fiberglass			<b>Threaded</b> <b>X</b>		
Blank casing diameter <b>2</b> in. to <b>18</b> Ft., Dia								
Casing height above land surface <b>FLUSH</b> in., weight <b>SCH 40</b> Lbs./ft. Wall thickness or gauge No.								
TYPE OF SCREEN OR PERFORATION MATERIAL:								
1 Steel 3 Stainless steel 5 Fiberglass 8 RMP (SR) 11 Other (specify)			7 <b>PVC</b> 10 Asbestos-cement					
2 Brass 4 Galvanized steel 6 Concrete tile 9 ABS 12 None used (open hole)			SCREEN OR PERFORATION OPENINGS ARE:					
1 Continuous slot 3 <b>Mill slot</b> 6 Gauzed wrapped 8 Saw cut 11 None (open hole)			2 Louvered shutter 4 Key punched 7 Wire wrapped 9 Drilled holes					
SCREEN-PERFORATED INTERVALS: From <b>18</b> ft. to <b>28</b> ft. From ft. to ft. From ft. to ft. From ft. to ft.			SAND PACK INTERVALS: From <b>16</b> ft. to <b>28</b> ft. From ft. to ft. From ft. to ft. From ft. to ft.					
6 GROUT MATERIAL: 1 Neat cement 2 Cement grout 3 <b>Bentonite</b> 4 Other								
Grout Intervals From 3 <b>16</b> ft. to <b>3</b> Ft. From 2 <b>3</b> to <b>0</b> ft. From ft. to ft.								
What is the nearest source of possible contamination:								
1 Septic tank 4 Lateral lines 7 Pit privy 10 Livestock pens 14 Abandoned water well			2 Sewer lines 5 Cess pool 8 Sewage lagoon 11 Fuel storage 15 Oil well/ Gas well					
3 Watertight sewer lines 6 Seepage pit 9 Feedyard 12 Fertilizer storage 16 <b>Other (specify below)</b>			<b>Contaminated Site</b>					
Direction from well? How many feet?								
FROM	TO	CODE	LITHOLOGIC LOG	FROM	TO	PLUGGING INTERVALS		
<b>0</b>	<b>5</b>		<b>Silty Clay</b>					
<b>5</b>	<b>12</b>		<b>Silty clay w/sand dark gray</b>					
<b>12</b>	<b>28</b>		<b>Silty clay, gray</b>					
<b>28</b>	<b>TD</b>		<b>End of Borehole</b>					
7 CONTRACTOR'S OR LANDOWNER'S CERTIFICATION: This water well was (x) constructed, (2) reconstructed, or (3) plugged under my jurisdiction and w								
Completed on (mo/day/yr) <b>03/26/07</b> And this record is true to the best of my knowledge and belief. Kansas								
Water Well Contractor's License No. <b>585</b> This Water Well Record was completed on (mo/day/yr) <b>04/26/07</b>								
under the business name of <b>Associated Environmental, Inc.</b> By (signature) <b>Bradley J. Johnson</b>								
INSTRUCTIONS: Please fill in blanks and circle the correct answers. Send three copies to Kansas Department of Health and Environment, Bureau of Water, Topeka, Kansas 66620-0001. Telephone: 913-296-5545. Send one to WATER WELL OWNER and retain one for your records.								

OFFICE USE ONLY

T

R

SEC