

17

Yd

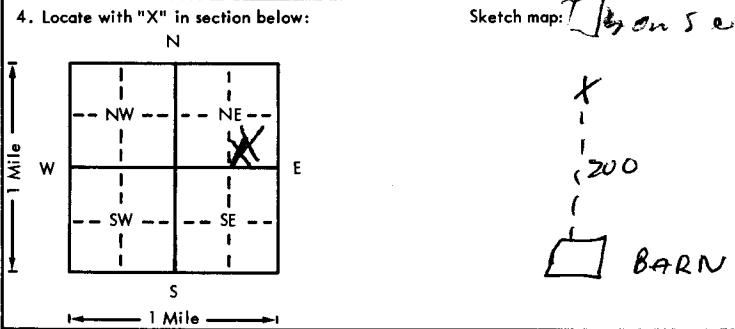
R

USE TYPEWRITER OR BALL POINT PEN-PRESS FIRMLY, PRINT CLEARLY.

WATER WELL RECORD
KSA 82a-1201-1215

Kansas Department of Health and Environment-Division of Environment
(Water well Contractors)
Topeka, Kansas 66620

SW SE NE ADL

1. Location of well:		County WABAUNSEE	Fraction SE 1/4 SE 1/4 NE 1/4	Section number 3	Township number T 12 S	Range number R 10 E
2. Distance and direction from nearest town or city: 1.5 N OF ALMA			3. Owner of well: Bill HAVENSTEIN R.R. or street: Box 223 City, state, zip code: ALMA, KS			
4. Locate with "X" in section below: 			6. Bore hole dia. 8 in. Completion date 7-20-77 Well depth 100 ft.			
5. Type and color of material			7. <input checked="" type="checkbox"/> Cable tool <input checked="" type="checkbox"/> Rotary <input type="checkbox"/> Driven <input type="checkbox"/> Dug <input type="checkbox"/> Hollow rod <input type="checkbox"/> Jetted <input type="checkbox"/> Bored <input type="checkbox"/> Reverse rotary			
			8. Use: <input checked="" type="checkbox"/> Domestic <input type="checkbox"/> Public supply <input type="checkbox"/> Industry <input type="checkbox"/> Irrigation <input type="checkbox"/> Air conditioning <input type="checkbox"/> Stock <input type="checkbox"/> Lawn <input type="checkbox"/> Oil field water <input type="checkbox"/> Other			
			9. Casing: Material PVC Height: Above or below Threaded <input type="checkbox"/> Welded <input type="checkbox"/> Surface 29 in. RMP <input type="checkbox"/> PVC 9L Weight 2.58 lbs./ft. Dia. 5 in. to 100 ft. depth Wall Thickness: inches or Dia. <input type="checkbox"/> in. to <input type="checkbox"/> ft. depth gage No. 158			
			10. Screen: Manufacturer's name MPI Type PVC Dia. 5 5/16 gauze 1020 Length 20 Set between 80 ft. and 100 ft. Gravel pack? <input checked="" type="checkbox"/> Size range of material: 30x100			
			11. Static water level: 70 ft. below land surface Date 7-20-77 mo./day/yr.			
			12. Pumping level below land surfaces: ____ ft. after ____ hrs. pumping ____ g.p.m. ____ ft. after ____ hrs. pumping ____ g.p.m. Estimated maximum yield 15 g.p.m.			
			13. Water sample submitted: ____ mo./day/yr. Yes <input checked="" type="checkbox"/> No <input type="checkbox"/> Date			
			14. Well head completion: Cap <input type="checkbox"/> Pitless adapter 24 inches above grade			
			15. Well grouted? <input checked="" type="checkbox"/> With: <input checked="" type="checkbox"/> Neat cement <input type="checkbox"/> Bentonite <input type="checkbox"/> Concrete Depth: From 0 ft. to 10 ft.			
			16. Nearest source of possible contamination: ft. 200 Direction S Type LOTS Well disinfected upon completion? <input checked="" type="checkbox"/> Yes <input type="checkbox"/> No			
			17. Pump: <input checked="" type="checkbox"/> Not installed Manufacturer's name _____ Model number _____ HP _____ Volts _____ Length of drop pipe _____ ft. capacity _____ g.p.m. Type: <input type="checkbox"/> Submersible <input type="checkbox"/> Turbine <input type="checkbox"/> Jet <input type="checkbox"/> Reciprocating <input type="checkbox"/> Centrifugal <input type="checkbox"/> Other			
18. Elevation: 140 Topography: <input checked="" type="checkbox"/> Hill <input type="checkbox"/> Slope <input type="checkbox"/> Upland <input type="checkbox"/> Valley			19. Remarks: OWNER TO INSTALL SLAB			20. Water well contractor's certification: This well was drilled under my jurisdiction and this report is true to the best of my knowledge and belief. STRADER DRIG CO INC. 182 Business name License No. Address HOLTON, KS Signed Dale Ashburn Date 7-27-77 Authorized representative

Forward the white, blue and pink copies to the Department of Health and Environment

Form WWC-5

BR = 1138

V = 1070

T
R
W
3
SE
NE
1/4
1/4
1/4