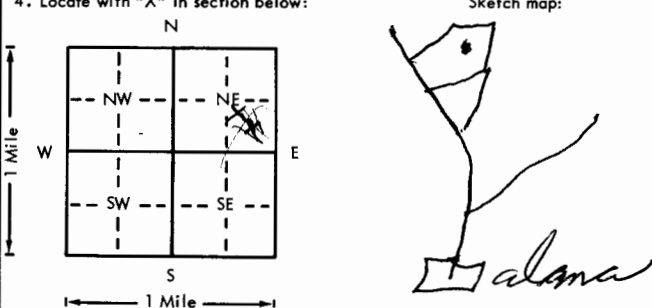


USE TYPEWRITER OR BALL  
POINT PEN-PRESS FIRMLY,  
PRINT CLEARLY.

WATER WELL RECORD  
KSA 82a-1201-1215

Kansas Department of Health and  
Environment-Division of Environment  
(Water well Contractors)  
Topeka, Kansas 66620

1. Location of well: County <u>Wabaunsee</u>		Fraction <u>N 1/2 SE 1/4 NE 1/4</u> 1/4 1/4 1/4	Section number <u>16</u>	Township number <u>T 12 S</u>	Range number <u>R 10 E/W</u>
2. Distance and direction from nearest town or city: <u>1/2 mile SW of Alma</u>		3. Owner of well: <u>Donald S. Falk</u> R.R. or street: <u>Alma, Kans. 66401</u> City, state, zip code: <u>Alma, Kans. 66401</u>			
4. Locate with "X" in section below: 		6. Bore hole dia. <u>9</u> in. Completion date <u>8-16-78</u> Well depth <u>142</u> ft.			
5. Type and color of material		From	To	7. <input type="checkbox"/> Cable tool <input checked="" type="checkbox"/> Rotary <input type="checkbox"/> Driven <input type="checkbox"/> Dug <input type="checkbox"/> Hollow rod <input type="checkbox"/> Jetted <input type="checkbox"/> Bored <input type="checkbox"/> Reverse rotary	
<u>Soil Top</u>		<u>0</u>	<u>1</u>	8. Use: <input checked="" type="checkbox"/> Domestic <input type="checkbox"/> Public supply <input type="checkbox"/> Industry <input type="checkbox"/> Irrigation <input type="checkbox"/> Air conditioning <input type="checkbox"/> Stock <input type="checkbox"/> Lawn <input type="checkbox"/> Oil field water <input type="checkbox"/> Other	
<u>Clay yellow</u>		<u>1</u>	<u>10</u>	9. Casing: Material <u>PVC</u> Height: Above or below Threaded <input type="checkbox"/> Welded <input type="checkbox"/> Surface <u>12</u> in. RMP <input type="checkbox"/> PVC <input type="checkbox"/> Weight <u>200</u> lbs./ft. Dia. <u>5</u> in. to <u>142</u> ft. depth Well Thickness: inches or Dia. <u>5</u> in. to <u>142</u> ft. depth <u>12</u> in. No. <u>200</u>	
<u>Rock Limestone white</u>		<u>10</u>	<u>14</u>	10. Screen: Manufacturer's name <u>Plastic</u> <u>NSF approved #200</u> Type <u>Plastic</u> Dia. <u>5</u> Slot/gauze <u>0.60</u> Length <u>60</u> Set between <u>60</u> ft. and <u>120</u> ft. ft. and <u>120</u> ft.	
<u>Clay Brown</u>		<u>14</u>	<u>16</u>	Gravel pack? <input checked="" type="checkbox"/> Size range of material <u>well gravel</u>	
<u>Limestone soft white</u>		<u>16</u>	<u>18</u>	11. Static water level: <u>60</u> ft. below land surface Date <u>8-16-78</u>	
<u>Shale Blue</u>		<u>18</u>	<u>25</u>	12. Pumping level below land surfaces: ft. after <u>    </u> hrs. pumping <u>    </u> g.p.m. ft. after <u>    </u> hrs. pumping <u>    </u> g.p.m. Estimated maximum yield <u>    </u> g.p.m.	
<u>Rock Limestone hard</u>		<u>25</u>	<u>26</u>	13. Water sample submitted: <u>    </u> mo./day/yr. <u>    </u> Yes <input checked="" type="checkbox"/> No <input type="checkbox"/> Date <u>    </u>	
<u>Limestone soft</u>		<u>26</u>	<u>28</u>	14. Well head completion: <u>Capped</u> <u>    </u> Pitless adapter <u>    </u> inches above grade	
<u>Limestone hard</u>		<u>28</u>	<u>29</u>	15. Well grouted? <u>yes</u> With: <u>    </u> Neat cement <u>    </u> Bentonite <input checked="" type="checkbox"/> Concrete Depth: From <u>0</u> ft. to <u>20</u> ft.	
<u>Clay yellow</u>		<u>29</u>	<u>33</u>	16. Nearest source of possible contamination: <u>none</u> ft. <u>    </u> Direction <u>    </u> Type <u>    </u> Well disinfected upon completion? <input checked="" type="checkbox"/> Yes <input type="checkbox"/> No	
<u>Rock Limestone soft</u>		<u>33</u>	<u>36</u>	17. Pump: <u>no</u> Not installed Manufacturer's name <u>    </u> Model number <u>    </u> HP <u>    </u> Volts <u>    </u> Length of drop pipe <u>    </u> ft. capacity <u>    </u> g.p.m. Type: <input type="checkbox"/> Submersible <input type="checkbox"/> Turbine <input type="checkbox"/> Jet <input type="checkbox"/> Reciprocating <input type="checkbox"/> Centrifugal <input type="checkbox"/> Other	
<u>Shale Gray</u>		<u>36</u>	<u>39</u>	20. Water well contractor's certification: This well was drilled under my jurisdiction and this report is true to the best of my knowledge and belief. <u>Blue Valley Drilling 234</u> Business name <u>Blue Valley Drilling</u> License No. <u>    </u> Address <u>Blue Valley Drilling</u> Signed <u>Gerald Shales</u> Date <u>8-30-78</u> Authorized representative	
<u>Rock Limestone</u>		<u>39</u>	<u>41</u>		
<u>Rock Limestone + Brown shale</u>		<u>41</u>	<u>51</u>		
<u>Rock Limestone + shale Blue</u>		<u>51</u>	<u>68</u>		
(Use a second sheet if needed)					
18. Elevation: <u>1109</u>		19. Remarks: <u>    </u>			
Topography: <input type="checkbox"/> Hill <input type="checkbox"/> Slope <input type="checkbox"/> Upland <input type="checkbox"/> Valley					

Forward the white, blue and pink copies to the Department of Health and Environment

Form WWC-5

no 2

Kansas Department of Health and  
Environment-Division of Environment  
(Water well Contractors)  
Topeka, Kansas 66620

	E	W	Sec	1/4	1/4	1/4
T						
R						

Form WWC-5