WATER WELL RECORD Form WWC-5 KSA 82a-1212

1 LOCATION OF WATER WELL: County: Wabaunsee | Fraction: SW ¼ SW ¼ NE ¼ | Section Number: 22 | Township Number: T 12 S | Range Number: R 10 E/W

Distance and direction from nearest town or city street address of well if located within city?
1 mile South of ALMA on west side of road (no House there)

2 WATER WELL OWNER: Maurice Stueve
RR#, St. Address, Box # :
City, State, ZIP Code : Alma Kans 66401

Board of Agriculture, Division of Water Resources
Application Number:

3 LOCATE WELL'S LOCATION WITH AN "X" IN SECTION BOX:

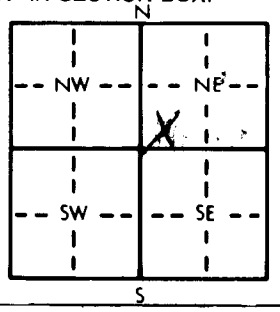

4 DEPTH OF COMPLETED WELL 88 ft. ELEVATION:
Depth(s) Groundwater Encountered 1. 75 ft. 2. ft. 3. ft.
WELL'S STATIC WATER LEVEL 60 ft. below land surface measured on mo/day/yr Aug 17 84
Pump test data: Well water was ft. after hours pumping gpm
Est. Yield 30 gpm: Well water was ft. after hours pumping gpm
Bore Hole Diameter 10 in. to 18 ft., and 6½ in. to 88' ft.
WELL WATER TO BE USED AS: (1) Domestic 2 Irrigation 3 Feedlot 4 Industrial 5 Public water supply 6 Oil field water supply 7 Lawn and garden only 8 Air conditioning 9 Dewatering 10 Observation well 11 Injection well 12 Other (Specify below)
Was a chemical/bacteriological sample submitted to Department? Yes ..... No X; If yes, mo/day/yr sample was submitted
Water Well Disinfected? Yes X No

5 TYPE OF BLANK CASING USED: (2) PVC
1 Steel 2 PVC 3 RMP (SR) 4 ABS 5 Wrought iron 6 Asbestos-Cement 7 Fiberglass 8 Concrete tile 9 Other (specify below)
CASING JOINTS: Glued X Clamped Welded Threaded
Blank casing diameter 5" in. to ~~Bottom~~ to ft., Dia 6 8' in. to and 20' Dia on bottom ft.
Casing height above land surface 12 in., weight 200 PSI lbs./ft. Wall thickness or gauge No. .267 Wall
TYPE OF SCREEN OR PERFORATION MATERIAL: (7) PVC
1 Steel 2 Brass 3 Stainless steel 4 Galvanized steel 5 Fiberglass 6 Concrete tile 7 PVC 8 RMP (SR) 9 ABS 10 Asbestos-cement 11 Other (specify) 12 None used (open hole)
SCREEN OR PERFORATION OPENINGS ARE: (8) Saw cut
1 Continuous slot 2 Louvered shutter 3 Mill slot 4 Key punched 5 Gauzed wrapped 6 Wire wrapped 7 Torch cut 8 Saw cut 9 Drilled holes 10 Other (specify) 11 None (open hole)
SCREEN-PERFORATED INTERVALS: From 88 ft. to 68 ft., From ft. to ft.
From ft. to ft., From ft. to ft.
GRAVEL PACK INTERVALS: From 88 ft. to 16 ft., From ft. to ft.
From ft. to ft., From ft. to ft.

6 GROUT MATERIAL: (1) Neat cement 2 Cement grout 3 Bentonite 4 Other
Grout Intervals: From 6 ft. to 18 ft., From ft. to ft., From ft. to ft.
What is the nearest source of possible contamination:
1 Septic tank 2 Sewer lines 3 Watertight sewer lines 4 Lateral lines 5 Cess pool 6 Seepage pit 7 Pit privy 8 Sewage lagoon 9 Feedyard 10 Livestock pens 11 Fuel storage 12 Fertilizer storage 13 Insecticide storage 14 Abandoned water well 15 Oil well/Gas well 16 Other (specify below) Cattle Feed lot
Direction from well? SOUTH How many feet? 660

FROM	TO	LITHOLOGIC LOG
0	3	top soil
3	8	clay, Brown
8	14	Rock, Limestone
14	20	clay, Blue
20	26	clay, yellow
26	34	Shale Blue
34	38	clay yellow
38	48	Chalk Red
48	58	Chalk yellow
58	74	Chalk Blue
74	84	Rock limestone
84	88	Rock Hard Blue

7 CONTRACTOR'S OR LANDOWNER'S CERTIFICATION: This water well was (1) constructed, (2) reconstructed, or (3) plugged under my jurisdiction and was completed on (mo/day/year) aug. 18 - 1984 and this record is true to the best of my knowledge and belief. Kansas Water Well Contractor's License No. 237 This Water Well Record was completed on (mo/day/yr) aug 18 - 1984 under the business name of Strader Drilling Co. by (signature) Harold Strader

INSTRUCTIONS: Use typewriter or ball point pen, *PLEASE PRESS FIRMLY* and *PRINT* clearly. Please fill in blanks, underline or circle the correct answers. Send top three copies to Kansas Department of Health and Environment, Division of Environment, Environmental Geology Section, Topeka, KS 66620. Send one to WATER WELL OWNER and retain one for your records.

OFFICE USE ONLY
T
R
E/W
SEC.
¼
¼
¼

the following-described real estate, situation in Wabaunsee

County and State of Kansas, to wit:

--All that part of Lot 4 in the Northeast one-quarter (NE¼) of Section 22, Township 12 S., Range 10 E. of the 6th P.M. in Wabaunsee County, Kansas, as follows:

Beginning at a point 550.00 feet East of the Northwest corner of Lot 4; the point of beginning of said tract, thence South 519.00 feet, thence West 339.00 feet, thence South 326.95 feet, thence South 66 degrees East 336.00 feet, thence North 73 degrees East 240.00 feet, thence North 19 degrees 30 minutes West 387.17 feet, thence North 544.48 feet to the North line of Lot 4, thence West 70.00 feet to the point of beginning, containing 5.25 acres, more or less, all in Wabaunsee County, Kansas.

No Buildings
1 So along West Side road – SW Corner of NE ¼