


LOCATION OF WATER WELL: County: WABASH CO Fraction: NW 1/4 SW 1/4 SW 1/4 Section Number: 36 Township Number: T 12 S Range Number: R 10 E

Distance and direction from nearest town or city street address of well if located within city? From ALMA Co 1 mile South on 99 Then Co 3 miles South on Township Road

WATER WELL OWNER: Eugene F. Bair RR#, St. Address, Box #: Topoka Kansas 66622 Board of Agriculture, Division of Water Resources Application Number:

LOCATE WELL'S LOCATION WITH AN "X" IN SECTION BOX:

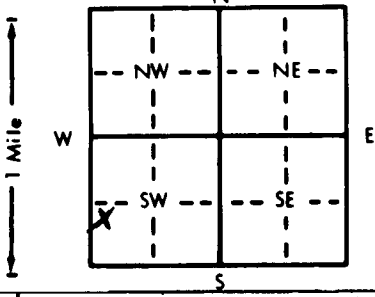

DEPTH OF COMPLETED WELL: 100' ft. ELEVATION: 68' ft.
 Depth(s) Groundwater Encountered: 1. 68' ft. 2. ft. 3. ft.
 WELL'S STATIC WATER LEVEL: 60' ft. below land surface measured on mo/day/yr
 Pump test data: Well water was ft. after hours pumping gpm
 Est. Yield: 1.5 gpm; Well water was ft. after hours pumping gpm
 Bore Hole Diameter: 8 in. to 100' ft., and in. to ft.
 WELL WATER TO BE USED AS:
 1 Domestic 3 Feedlot 6 Oil field water supply 9 Dewatering 12 Other (Specify below)
 2 Irrigation 4 Industrial 7 Lawn and garden only 10 Observation well
 Was a chemical/bacteriological sample submitted to Department? Yes No ; If yes, mo/day/yr sample was submitted
 Water Well Disinfected? Yes No

TYPE OF BLANK CASING USED:
 1 Steel 3 RMP (SR) 6 Asbestos-Cement 9 Other (specify below)
 2 PVC 4 ABS 7 Fiberglass 8 Concrete tile CASING JOINTS: Glued Screwed Clamped Welded Threaded

Blank casing diameter: 5 in. to 80' ft., Dia. in. to ft., Dia. in. to ft.
 Casing height above land surface: 2' in., weight 5.4 lbs./ft. Wall thickness or gauge No.

TYPE OF SCREEN OR PERFORATION MATERIAL:
 1 Steel 3 Stainless steel 5 Fiberglass 7 PVC 10 Asbestos-cement
 2 Brass 4 Galvanized steel 6 Concrete tile 8 RMP (SR) 11 Other (specify)
 12 None used (open hole)

SCREEN OR PERFORATION OPENINGS ARE: 3/1000's
 1 Continuous slot 5 Gauzed wrapped 8 Saw cut 11 None (open hole)
 2 Louvered shutter 3 Mill slot 6 Wire wrapped 9 Drilled holes
 4 Key punched 7 Torch cut 10 Other (specify)

SCREEN-PERFORATED INTERVALS: From 80 ft. to 100' ft., From ft. to ft., From ft. to ft.
 GRAVEL PACK INTERVALS: From 25 ft. to 100' ft., From ft. to ft., From ft. to ft.

GROUT MATERIAL: 1 Neat cement 2 Cement grout 3 Bentonite 4 Other
 Grout Intervals: From 0 ft. to 25' ft., From ft. to ft., From ft. to ft.

What is the nearest source of possible contamination:
 1 Septic tank 4 Lateral lines 7 Pit privy 10 Livestock pens 14 Abandoned water well
 2 Sewer lines 5 Cess pool 8 Sewage lagoon 11 Fuel storage 15 Oil well/Gas well
 3 Watertight sewer lines 6 Seepage pit 9 Feedyard 12 Fertilizer storage 16 Other (specify below)
 13 Insecticide storage
 Direction from well? South East How many feet? 90'

FROM	TO	LITHOLOGIC LOG	FROM	TO	LITHOLOGIC LOG
0	6	Grey Clay			
6	7	Rock			
7	12	Brown Clay			
12	16	Rock			
16	53	Brown Clay			
53	67	Rock (WATIC)			
67	74	Grey Shale			
74	77	Rock			
77	84	Blue Shale			
84	87	Rock			
87	90	Blue Shale			
90	96	Rock			
96	100	Blue Shale			

CONTRACTOR'S OR LANDOWNER'S CERTIFICATION: This water well was (1) constructed, (2) reconstructed, or (3) plugged under my jurisdiction and was completed on (mo/day/year) 3/15/86 and this record is true to the best of my knowledge and belief. Kansas Water Well Contractor's License No. 451 This Water Well Record was completed on (mo/day/yr) 4/5/88 under the business name of Haldeman Well Drilling by (signature)

INSTRUCTIONS: Use typewriter or ball point pen. PLEASE PRESS FIRMLY and PRINT clearly. Please fill in blanks, underline or circle the correct answers. Send top three copies to Kansas Department of Health and Environment, Bureau of Water Protection, Topeka, Kansas 66620-7320, Telephone: 913-862-9360. Send one to WATER WELL OWNER and retain one for your records.