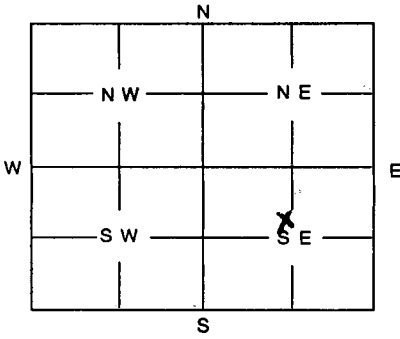


1	LOCATION OF WATER WELL:	Fraction	Section	Number	Township	Number	Range	Number
County:	<i>Wabunsee</i>	<i>SE 1/4 1/4 1/4</i>	<i>17</i>		<i>12</i>		<i>11 E</i>	

Distance and direction from nearest town or city street address of well if located within city?

2	WATER WELL OWNER: <i>FRED GNADT</i>	Board of Agriculture, Division of Water Resources
	RR #, St. Address, Box #: <i>RR2 Box 9C</i>	Application Number:
	City, State, ZIP Code: <i>Alma, KS 66401</i>	

3	MARK WELL'S LOCATION WITH AN "X" IN SECTION BOX:	4	DEPTH OF WELL <i>not known</i>
		WELL'S STATIC WATER LEVEL <i>not known</i> WELL WAS USED AS: <input checked="" type="radio"/> 1 Domestic 5 Public Water Supply 9 Dewatering <input type="radio"/> 2 Irrigation 6 Oil Field Water Supply 10 Monitoring Well <input type="radio"/> 3 Feedlot 7 Domestic (Lawn & Garden) 11 Injection Well <input type="radio"/> 4 Industrial 8 Air Conditioning 12 Other	
Was a chemical / bacteriological sample submitted to Department? Yes No <input checked="" type="checkbox"/> If yes, mo/day/yr sample was submitted			
Water Well Disinfected: Yes No <input checked="" type="checkbox"/>			

5	TYPE OF BLANK CASING USED:
	1 Steel 3 RMP (SR) 5 Wrought 7 Fiberglass 9 Other (Specify below) <i>60" hand dug</i> 2 PVC 4 ABS 6 Asbestos-Cement 8 Concrete Tile
Blank casing diameter in. Was casing pulled? Yes No <input checked="" type="checkbox"/> If yes, how much Casing height above or below land surface in.	

6	GROUT PLUG MATERIAL:	1 Neat cement 2 Cement grout <input checked="" type="radio"/> 3 Bentonite 4 Other
Grout Plug Intervals: From ft. to ft., From ft. to ft., From ft. to ft.		
What is the nearest source of possible contamination: 1 Septic tank 6 Seepage pit 11 Fuel storage 16 Other (specify below) 2 Sewer lines 7 Pit privy 12 Fertilizer storage 3 Watertight sewer lines 8 Sewage lagoon 13 Insecticide storage 4 Lateral lines 9 Feedyard <input checked="" type="radio"/> 14 Abandoned water well 5 Cess Pool <input checked="" type="radio"/> 10 Livestock pens 15 Oil well/Gas well		
Direction from well? <i>EAST</i> How many feet?		

FROM	TO	PLUGGING MATERIALS
<i>4 1/2'</i>	<i>top</i>	<i>dirt</i>
<i>3'</i>	<i>4 1/2'</i>	<i>bentonite</i>

This well was filled in (not measured) but needed bentonite & excavating for dirt cover) well was in the creek and water during rains ran over & into this old filled up well

7	CONTRACTOR'S OR LANDOWNER'S CERTIFICATION: This water well was plugged under my jurisdiction and was completed on (mo/day/year) and this record is true to the best of my knowledge and belief. Kansas Water Well Contractor's License No. This Water Well Record was completed on (mo/day/year)
	by (signature) <i>Fred A. Gnadt</i> under the business name of

INSTRUCTIONS: Use typewriter or ball point pen. Please press firmly and print clearly. Please fill in blanks, underline or circle the correct answers. Send top three copies to Kansas Department of Health and Environment, Bureau of Water, Topeka, Kansas 66620-0001. Telephone: 785/296-3565. Send one to Water Well Owner and retain one for your records.