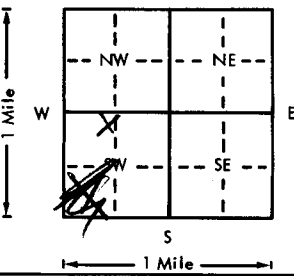
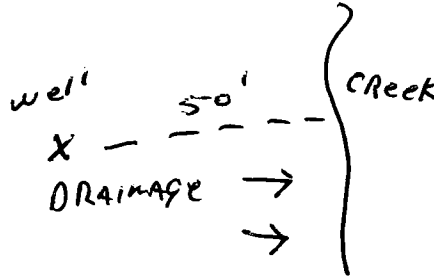


USE TYPEWRITER OR BALL
POINT PEN-PRESS FIRMLY,
PRINT CLEARLY.

WATER WELL RECORD
KSA 82a-1201-1215

Kansas Department of Health and
Environment-Division of Environment
(Water well Contractors)
Topeka, Kansas 66620

NE NW SW CBA

1. Location of well:		County Wabaunsee	Fraction SW 1/4	Section number 12	Township number T 12 S	Range number R 11 E
2. Distance and direction from nearest town or city: 3 S. of PAXICO				3. Owner of well: WAYNE CLARK R.R. or street: 5609 W. 14th City, state, zip code: TOPEKA, KAN. 66601		
4. Locate with "X" in section below:		Sketch map:		6. Bore hole dia. 10 in. Completion date 12-1-77 Well depth 40 ft.		
				7. <input checked="" type="checkbox"/> Cable tool <input checked="" type="checkbox"/> Rotary <input type="checkbox"/> Driven <input type="checkbox"/> Dug <input type="checkbox"/> Hollow rod <input type="checkbox"/> Jetted <input type="checkbox"/> Bored <input type="checkbox"/> Reverse rotary		
5. Type and color of material				From	To	8. Use: <input checked="" type="checkbox"/> Domestic <input type="checkbox"/> Public supply <input type="checkbox"/> Industry <input type="checkbox"/> Irrigation <input type="checkbox"/> Air conditioning <input type="checkbox"/> Stock <input type="checkbox"/> Lawn <input type="checkbox"/> Oil field water <input type="checkbox"/> Other
TOP SOIL				0	3	9. Casing: Material PVC Height: above or below Threaded <input type="checkbox"/> Welded <input type="checkbox"/> Surface 36 in. RMP <input type="checkbox"/> PVC 96 Weight 2.58 lbs./ft. Dia. 5 in. to 40 ft. depth Wall Thickness: inches or Dia. <input type="checkbox"/> in. to <input type="checkbox"/> ft. depth gage No. 274
Clay, BROWN				3	12	10. Screens: Manufacturer's name Pumpco Mfg. Type PVC Dia. 5 Slot/gauze 020 Length 10 Set between 12 ft. and 22 ft. Gravel pack? <input checked="" type="checkbox"/> Size range of material 10-30 mesh
SANDY CLAY, loose Limestone				12	15	11. Static water level: 10 ft. below land surface Date 12-1-77 mo./day/yr.
Shale, grey, Limestone, grey				15	40	12. Pumping level below land surfaces: ____ ft. after ____ hrs. pumping ____ g.p.m. ____ ft. after ____ hrs. pumping ____ g.p.m. Estimated maximum yield 10 g.p.m.
						13. Water sample submitted: ____ mo./day/yr. Yes <input checked="" type="checkbox"/> No <input type="checkbox"/> Date
						14. Well head completion: CAP ____ Pitless adapter 36 inches above grade
						15. Well grouted? <input checked="" type="checkbox"/> With: <input checked="" type="checkbox"/> Neat cement <input type="checkbox"/> Bentonite <input type="checkbox"/> Concrete Depth: From 0 ft. to 10 ft.
						16. Nearest source of possible contamination: ft. 50 Direction E Type check Well disinfected upon completion? <input checked="" type="checkbox"/> Yes <input type="checkbox"/> No
						17. Pump: <input checked="" type="checkbox"/> Not installed Manufacturer's name Model number ____ HP ____ Volts ____ Length of drop pipe ____ ft. capacity ____ g.p.m. Type: <input type="checkbox"/> Submersible <input type="checkbox"/> Turbine <input type="checkbox"/> Jet <input type="checkbox"/> Reciprocating <input type="checkbox"/> Centrifugal <input type="checkbox"/> Other
						20. Water well contractor's certification: This well was drilled under my jurisdiction and this report is true to the best of my knowledge and belief. STANLEY DRUG CO. INC. License No. 182 Business name Address 1111 HOLTEN, KS Signed Dale Peterson Date 12-5-77 Authorized representative
18. Elevation: 1041 ft. Topography <input type="checkbox"/> Hill <input checked="" type="checkbox"/> Slope <input type="checkbox"/> Upland <input type="checkbox"/> Valley		19. Remarks: OWNER TO INSTALL SLAB				

Forward the white, blue and pink copies to the Department of Health and Environment

Form WWC-5