


1 LOCATION OF WATER WELL: County: WABAUNSEE Fraction: SE 1/4 SE 1/4 SW 1/4 Section Number: 32 Township Number: T 12 S Range Number: R 12 E

Distance and direction from nearest town or city street address of well if located within city?
6.5 MILES NORTH OF ESKRIDGE ON HWY 4, 1.5 MILES WEST

2 WATER WELL OWNER: RON HARTLEIN
 RR#, St. Address, Box #: ROUTE 1, BOX 164A
 City, State, ZIP Code: ESKRIDGE, KS 66423
 Board of Agriculture, Division of Water Resources
 Application Number: _____

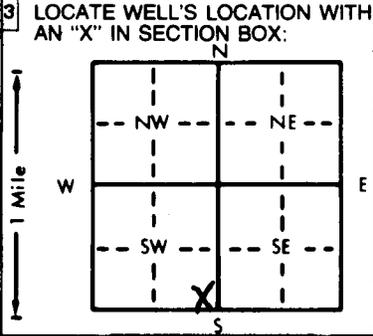

4 DEPTH OF COMPLETED WELL: 105 ft. ELEVATION: _____
 Depth(s) Groundwater Encountered: 1. 86 ft. 2. _____ ft. 3. _____ ft.
 WELL'S STATIC WATER LEVEL: 80 ft. below land surface measured on mo/day/yr 3/6/00
 Pump test data: Well water was _____ ft. after _____ hours pumping _____ gpm
 Est. Yield: 3 gpm. Well water was _____ ft. after _____ hours pumping _____ gpm
 Bore Hole Diameter: 8.75 in. to 8.5 in. ft., and _____ in. to _____ in. ft.
 WELL WATER TO BE USED AS:
 1 Domestic 2 Irrigation 3 Feedlot 4 Industrial
 5 Public water supply 6 Oil field water supply 7 Lawn and garden only
 8 Air conditioning 9 Dewatering 10 Monitoring well
 11 Injection well 12 Other (Specify below) _____
 Was a chemical/bacteriological sample submitted to Department? Yes _____ No If yes, mo/day/yr sample was submitted _____
 Water Well Disinfected? Yes No _____

5 TYPE OF BLANK CASING USED:
 1 Steel 2 PVC 3 RMP (SR) 4 ABS 5 Wrought iron 6 Asbestos-Cement 7 Fiberglass 8 Concrete tile 9 Other (specify below) _____
 Blank casing diameter: 5 in. to 8.5 ft., Dia. _____ in. to _____ ft., Dia. _____ in. to _____ ft.
 Casing height above land surface: 18 in., weight _____ lbs./ft. Wall thickness or gauge No. SDR 26
 TYPE OF SCREEN OR PERFORATION MATERIAL:
 1 Steel 2 Brass 3 Stainless steel 4 Galvanized steel 5 Fiberglass 6 Concrete tile 7 PVC 8 RMP (SR) 9 ABS 10 Asbestos-cement 11 Other (specify) _____ 12 None used (open hole) _____
 SCREEN OR PERFORATION OPENINGS ARE:
 1 Continuous slot 2 Louvered shutter 3 Mill slot 4 Key punched 5 Gauzed wrapped 6 Wire wrapped 7 Torch cut 8 Saw cut 9 Drilled holes 10 Other (specify) _____ 11 None (open hole) _____
 SCREEN-PERFORATED INTERVALS: From 85 ft. to 105 ft., From _____ ft. to _____ ft., From _____ ft. to _____ ft.
 GRAVEL PACK INTERVALS: From 25 ft. to 105 ft., From _____ ft. to _____ ft., From _____ ft. to _____ ft.

6 GROUT MATERIAL: 1 Neat cement 2 Cement grout 3 Bentonite 4 Other _____
 Grout Intervals: From 0 ft. to 25 ft., From _____ ft. to _____ ft., From _____ ft. to _____ ft.
 What is the nearest source of possible contamination:
 1 Septic tank 2 Sewer lines 3 Watertight sewer lines 4 Lateral lines 5 Cess pool 6 Seepage pit 7 Pit privy 8 Sewage lagoon 9 Feedyard 10 Livestock pens 11 Fuel storage 12 Fertilizer storage 13 Insecticide storage 14 Abandoned water well 15 Oil well/Gas well 16 Other (specify below) _____
 Direction from well? NORTH
 How many feet? 300 PLUS

FROM	TO	LITHOLOGIC LOG	FROM	TO	PLUGGING INTERVALS
0	2	SOIL			
2	19	LIMESTONE, YELLOW			
19	27	SHALE, GRAY			
27	36	SHALE, BROWN			
36	50	SHALE, GRAY			
50	53	LIMESTONE, GRAY			
53	59	SHALE, GRAY			
59	62	SHALE, DARK GRAY			
62	68	SHALE, GRAY			
68	70	LIMESTONE, GRAY			
70	85	SHALE, GRAY			
85	86	LIMESTONE			
86	93	SHALE, GRAY			
93	96	LIMESTONE			
96	105	SHALE, GRAY			

105 TOTAL DEPTH

7 CONTRACTOR'S OR LANDOWNER'S CERTIFICATION: This water well was (1) constructed, (2) reconstructed, or (3) plugged under my jurisdiction and was completed on (mo/day/year) 3/6/00 and this record is true to the best of my knowledge and belief. Kansas Water Well Contractor's License No. 585 This Water Well Record was completed on (mo/day/yr) 3/10/00 under the business name of ASSOC ENVIRONMENTAL WITH INC by (signature) _____

OFFICE USE ONLY
T
R
EW
SEC.