CORRECTION(S) TO WATER WEL	IL RECURD (WWC-5)
(to rectify lacking or incorrect	t information)
	County: Wabaunsee
Location listed as:	Location changed to:
Section-Township-Range: None Given	26-125-12E
Fraction (½ ¼ ¼):	SE SE SE NE SW
Other changes: Initial statements:	

Changed to:

verification method: Latitude and longitude, conversion tool on


KGS website, and mapping tool on KGS website.

initials: ORL date: 6/9/2006

submitted by: Kansas Geological Survey, Data Resources Library, 1930 Constant Ave., Lawrence, KS 66047-3726 to: Kansas Dept of Health & Environment, Bureau of Water, 1000 SW Jackson, Suite 420, Topeka, KS 66612-1367.

Forbes Missile Site Slo

1DNOS6-MWI-01 Number Range Number E/W Dewatering 10 Monitoring Well 11 Injection Well 12 Other

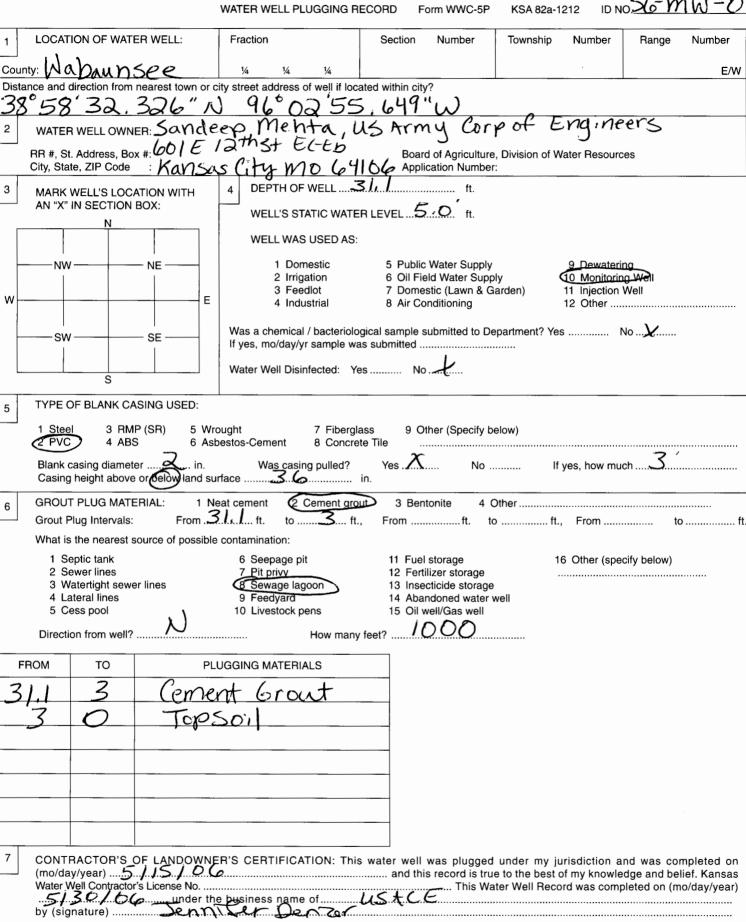

INSTRUCTIONS: Use typewriter or ball point pen. Please press firmly and print clearly. Please fill in blanks, underline or circle the correct answers. Send top three copies to Kansas Department of Health and Environment, Bureau of Water, Geology Section, 1000 SW Jackson St., Ste. 420, Topeka, Kansas 66612-1367. Telephone: 785/296-5522. Send one to Water Well Owner and retain one for your records.