

CORRECTION(S) TO WATER WELL RECORD (WWC-5)

(to rectify lacking or incorrect information)

Location listed as:

Section-Township-Range: None Given

Fraction ($\frac{1}{4}$ $\frac{1}{4}$ $\frac{1}{4}$): _____

County: Wabaunsee

Location changed to:

26-12 S-12 E

NE NE SE SW

Other changes: Initial statements: _____

Changed to: _____

Comments: _____

verification method: Latitude and longitude, conversion tool on
KGS website, and mapping tool on KGS website.

initials: _____ date: _____

submitted by: Kansas Geological Survey, Data Resources Library, 1930 Constant Ave., Lawrence, KS 66047-3726

to: Kansas Dept of Health & Environment, Bureau of Water, 1000 SW Jackson, Suite 420, Topeka, KS 66612-1367.

Forbes Missile Site S6

WATER WELL PLUGGING RECORD

Form WWC-5P

KSA 82a-1212

ID NO.

S6-mw-06

1	LOCATION OF WATER WELL:	Fraction	Section	Number	Township	Number	Range	Number
County: <u>Wabaunsee</u>		$\frac{1}{4}$ $\frac{1}{4}$ $\frac{1}{4}$						E/W

Distance and direction from nearest town or city street address of well if located within city?

38° 58' 30.737" N 96° 02' 55.817" W

2 WATER WELL OWNER: Sandeep Mehta, US Army Corp of Engineers


RR #, St. Address, Box #: 601 E 12th St EC-ED

Board of Agriculture, Division of Water Resources

City, State, ZIP Code : Kansas City, MO 64106

Application Number:

3 MARK WELL'S LOCATION WITH AN "X" IN SECTION BOX:

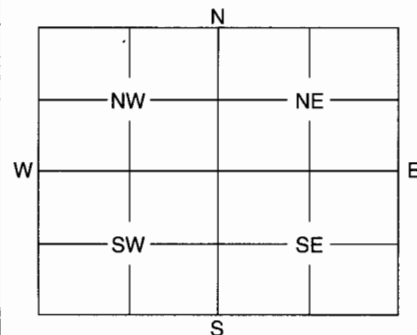

4 DEPTH OF WELL 29.0 ft.

WELL'S STATIC WATER LEVEL 8.2' ft.

WELL WAS USED AS:

- 1 Domestic
- 2 Irrigation
- 3 Feedlot
- 4 Industrial

- 5 Public Water Supply
- 6 Oil Field Water Supply
- 7 Domestic (Lawn & Garden)
- 8 Air Conditioning

- 9 Dewatering
- 10 Monitoring Well
- 11 Injection Well
- 12 Other

Was a chemical / bacteriological sample submitted to Department? Yes No X.....
If yes, mo/day/yr sample was submitted

Water Well Disinfected: Yes No X.....

5 TYPE OF BLANK CASING USED:

- 1 Steel
- 2 PVC
- 3 RMP (SR)
- 4 ABS
- 5 Wrought
- 6 Asbestos-Cement
- 7 Fiberglass
- 8 Concrete Tile
- 9 Other (Specify below)

Blank casing diameter 2 in. Was casing pulled? Yes X No If yes, how much 3'
Casing height above or below land surface 36 in.

6 GROUT PLUG MATERIAL: 1 Neat cement 2 Cement grout 3 Bentonite 4 Other

Grout Plug Intervals: From 29.0 ft. to 3 ft., From ft. to ft., From to ft.

What is the nearest source of possible contamination:

- 1 Septic tank
- 2 Sewer lines
- 3 Watertight sewer lines
- 4 Lateral lines
- 5 Cess pool
- 6 Seepage pit
- 7 Pit privy
- 8 Sewage lagoon
- 9 Feedyard
- 10 Livestock pens
- 11 Fuel storage
- 12 Fertilizer storage
- 13 Insecticide storage
- 14 Abandoned water well
- 15 Oil well/Gas well
- 16 Other (specify below)

Direction from well? N How many feet? 1000

FROM	TO	PLUGGING MATERIALS
<u>29.0</u>	<u>3</u>	<u>Cement Grout</u>
<u>3</u>	<u>0</u>	<u>Top Soil</u>

7 CONTRACTOR'S OF LANDOWNER'S CERTIFICATION: This water well was plugged under my jurisdiction and was completed on (mo/day/year) 5/15/06 and this record is true to the best of my knowledge and belief. Kansas Water Well Contractor's License No. This Water Well Record was completed on (mo/day/year) 5/30/06 under the business name of USACE
by (signature) Jennifer Denzer

INSTRUCTIONS: Use typewriter or ball point pen. Please press firmly and print clearly. Please fill in blanks, underline or circle the correct answers. Send top three copies to Kansas Department of Health and Environment, Bureau of Water, Geology Section, 1000 SW Jackson St., Ste. 420, Topeka, Kansas 66612-1367. Telephone: 785/296-5522. Send one to Water Well Owner and retain one for your records.