


1 LOCATION OF WATER WELL: Fraction SE 1/4 NE 1/4 NW 1/4 Section Number 29 Township Number T 12 S Range Number R 12 E/W  
 County: WABAUNSEE

Distance and direction from nearest town or city street address of well if located within city?  
3 1/2 miles west, 1 3/4 north of Keene

2 WATER WELL OWNER: Butch Stuckey  
 RR#, St. Address, Box # : Box 109A Board of Agriculture, Division of Water Resources  
 City, State, ZIP Code : Paxico, KS 66526 Application Number:

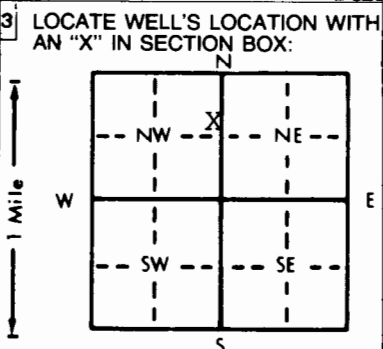

4 DEPTH OF COMPLETED WELL: 200 ft. ELEVATION: .....  
 Depth(s) Groundwater Encountered 1. 90' ft. 2. .... ft. 3. .... ft.  
 WELL'S STATIC WATER LEVEL 84' ft. below land surface measured on mo/day/yr 12-20-88  
 Pump test data: Well water was ..... ft. after ..... hours pumping ..... gpm  
 Est. Yield 5 ~~gpm~~ gallon per hour Well water was ..... ft. after ..... hours pumping ..... gpm  
 Bore Hole Diameter: 8 3/4 in. to ..... ft., and ..... in. to ..... ft.  
 WELL WATER TO BE USED AS: 5 Public water supply 8 Air conditioning 11 Injection well  
 1 Domestic 3 Feedlot 6 Oil field water supply 9 Dewatering 12 Other (Specify below)  
 2 Irrigation 4 Industrial 7 Lawn and garden only 10 Monitoring well .....  
 Was a chemical/bacteriological sample submitted to Department? Yes.....No...X.....; If yes, mo/day/yr sample was sub-  
 mitted Water Well Disinfected? Yes X No

5 TYPE OF BLANK CASING USED: 5 Wrought iron 8 Concrete tile CASING JOINTS: Glued X Clamped .....  
 1 Steel 3 RMP (SR) 6 Asbestos-Cement 9 Other (specify below) Welded .....  
 2 PVC 4 ABS 7 Fiberglass ..... Threaded.....  
 Blank casing diameter ..... 5" in. to 0-85 ..... ft., Dia ..... 5" in. to 120-200 ..... ft., Dia ..... in. to ..... ft.  
 Casing height above land surface: ..... 24" in., weight ..... 2.82 ..... lbs./ft. Wall thickness or gauge No. 258  
 TYPE OF SCREEN OR PERFORATION MATERIAL: 7 PVC 10 Asbestos-cement  
 1 Steel 3 Stainless steel 5 Fiberglass 8 RMP (SR) 11 Other (specify) .....  
 2 Brass 4 Galvanized steel 6 Concrete tile 9 ABS 12 None used (open hole)  
 SCREEN OR PERFORATION OPENINGS ARE: 5 Gauzed wrapped 8 Saw cut 11 None (open hole)  
 1 Continuous slot 3 Mill slot 6 Wire wrapped 9 Drilled holes  
 2 Louvered shutter 4 Key punched 7 Torch cut 10 Other (specify) .....  
 SCREEN-PERFORATED INTERVALS: From ..... 85 ..... ft. to ..... 120 ..... ft., From ..... ft. to ..... ft.  
 From ..... ft. to ..... ft., From ..... ft. to ..... ft.  
 GRAVEL PACK INTERVALS: From ..... 24 ..... ft. to ..... 200 ..... ft., From ..... ft. to ..... ft.  
 From ..... ft. to ..... ft., From ..... ft. to ..... ft.

6 GROUT MATERIAL: 1 Neat cement 2 Cement grout 3 Bentonite 4 Other .....  
 Grout Intervals: From ..... 4 ..... ft. to ..... 24 ..... ft., From ..... ft. to ..... ft., From ..... ft. to ..... ft.  
 What is the nearest source of possible contamination:  
 1 Septic tank 4 Lateral lines 7 Pit privy 10 Livestock pens 14 Abandoned water well  
 2 Sewer lines 5 Cess pool 8 Sewage lagoon 11 Fuel storage 15 Oil well/Gas well  
 3 Watertight sewer lines 6 Seepage pit 9 Feedyard 12 Fertilizer storage 16 Other (specify below)  
 13 Insecticide storage .....  
 Direction from well? N How many feet? 110

FROM	TO	LITHOLOGIC LOG	FROM	TO	PLUGGING INTERVALS
0	6	Limestone-loose	211	213	Limestone-Grey
6	20	Shale-Yellow	213	224	Shale-Grey
20	21	Limestone-Grey	224	226	Limestone-grey
21	73	Shale-Yellow	226	228	Shale-grey
73	75	Limestone-Yellow	228	232	Limestone-grey
75	84	Shale-Yellow	232	238	Shale-grey
84	87	Limestone-Yellow-loose	238	241	Limestone-Grey
87	90	Shale-Yellow	241	280	Shale-Grey
90	95	Limestone-Yellow			
95	121	Shaley Limestone			
121	133	Shale-Grey			
133	154	Limestone-Grey			
154	181	Shale-Grey			
181	187	Limestone-grey			
187	211	Shale-Grey			

7 CONTRACTOR'S OR LANDOWNER'S CERTIFICATION: This water well was (1) constructed, (2) reconstructed, or (3) plugged under my jurisdiction and was completed on (mo/day/year) 12-20-88 and this record is true to the best of my knowledge and belief. Kansas Water Well Contractor's License No. 182 This Water Well Record was completed on (mo/day/yr) 1-9-89 under the business name of STRADER DRILLING CO., INC. by (signature) Delbert Stuckey

INSTRUCTIONS: Use typewriter or ball point pen. PLEASE PRESS FIRMLY and PRINT clearly. Please fill in blanks, underline or circle the correct answers. Send top three copies to Kansas Department of Health and Environment, Bureau of Water Protection, Topeka, Kansas 66620-7320. Telephone: 913-296-5514. Send one to WATER WELL OWNER and retain one for your records.