WATER WELL RECORD Form WWC-5 KSA 82a-1212

1 LOCATION OF WATER WELL: County: WABAUNSEE | Fraction: SE ¼ SW ¼ SW ¼ | Section Number: 26 | Township Number: T 12 S | Range Number: R 12 E/W

Distance and direction from nearest town or city street address of well if located within city?
1 north, 3/4 west of Keene

2 WATER WELL OWNER: Shane Cooper
RR#, St. Address, Box # : Rt. 1 Box 160D
City, State, ZIP Code : Eskridge, KS 66423
Board of Agriculture, Division of Water Resources
Application Number:

3 LOCATE WELL'S LOCATION WITH AN "X" IN SECTION BOX:

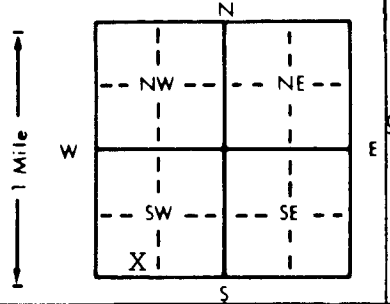

4 DEPTH OF COMPLETED WELL 158' ft. ELEVATION:
Depth(s) Groundwater Encountered 1. 50' ft. 2. ft. 3. ft.
WELL'S STATIC WATER LEVEL 46' ft. below land surface measured on mo/day/yr 9-06-94
Pump test data: Well water was ft. after hours pumping gpm
Est. Yield 8 ~~gpm~~ gal. per hr. Well water was ft. after hours pumping gpm
Bore Hole Diameter 8 3/4 in. to ft., and in. to ft.

WELL WATER TO BE USED AS: 1 Domestic 2 Irrigation 3 Feedlot 4 Industrial 5 Public water supply 6 Oil field water supply 7 Lawn and garden only 8 Air conditioning 9 Dewatering 10 Monitoring well 11 Injection well 12 Other (Specify below)

Was a chemical/bacteriological sample submitted to Department? Yes No X; If yes, mo/day/yr sample was submitted
Water Well Disinfected? Yes X No

5 TYPE OF BLANK CASING USED: 1 Steel 2 PVC 3 RMP (SR) 4 ABS 5 Wrought iron 6 Asbestos-Cement 7 Fiberglass 8 Concrete tile 9 Other (specify below)
CASING JOINTS: Glued X Clamped Welded Threaded

Blank casing diameter 5" 0-50 in. to 5" 55-75 ft., Dia 5" 80-100 in. to 5" 105-125 Dia 5" in. to 130-158 ft.
Casing height above land surface 24" in., weight 2.82 lbs./ft. Wall thickness or gauge No. .258

TYPE OF SCREEN OR PERFORATION MATERIAL: 1 Steel 2 Brass 3 Stainless steel 4 Galvanized steel 5 Fiberglass 6 Concrete tile 7 PVC 8 RMP (SR) 9 ABS 10 Asbestos-cement 11 Other (specify) 12 None used (open hole)

SCREEN OR PERFORATION OPENINGS ARE: 1 Continuous slot 2 Louvered shutter 3 Mill slot 4 Key punched 5 Gauzed wrapped 6 Wire wrapped 7 Torch cut 8 Saw cut 9 Drilled holes 10 Other (specify) 11 None (open hole)

SCREEN-PERFORATED INTERVALS: From 50 ft. to 55 ft., From 75 ft. to 80 ft.
From 100 ft. to 105 ft., From 125 ft. to 130 ft.
GRAVEL PACK INTERVALS: From ft. to ft., From ft. to ft.
From ft. to ft., From ft. to ft.

6 GROUT MATERIAL: 1 Neat cement 2 Cement grout 3 Bentonite 4 Other
Grout Intervals: From 4 ft. to 24 ft., From ft. to ft., From ft. to ft.

What is the nearest source of possible contamination:
1 Septic tank 2 Sewer lines 3 Watertight sewer lines 4 Lateral lines 5 Cess pool 6 Seepage pit 7 Pit privy 8 Sewage lagoon 9 Feedyard 10 Livestock pens 11 Fuel storage 12 Fertilizer storage 13 Insecticide storage 14 Abandoned water well 15 Oil well/Gas well 16 Other (specify below)
Direction from well? west How many feet? 330'

FROM	TO	LITHOLOGIC LOG	FROM	TO	PLUGGING INTERVALS
0	9	Clay-Brown	91	101	Shale-Grey
9	14	Shale-Grey	101	115	Shaley Limestone-Grey
14	18	Limestone-Tan	115	116	Limestone-Grey
18	23	Shale-Grey	116	123	Shale-Grey
23	24	Limestone-Grey	123	125	Limestone-Grey
24	40	Shale-Grey	125	127	Shale-Grey
40	45	Limestone-Grey	127	128	Limestone-Grey
45	59	Shale-grey	128	131	Shale-Grey
59	62	Shale-Red	131	135	Limestone-Tan
62	67	Shale-Grey	135	141	Shale-Grey
67	68	Limestone-Grey	141	146	Sandy Shale-Grey
68	82	Shale-Grey	146	150	Shale-Grey
82	89	Shaley Limestone-Grey	150	152	Limestone-Grey
89	90	Shale-Grey	152	158	Shale-Grey
90	91	Limestone-Grey	158	160	Limestone-Grey

7 CONTRACTOR'S OR LANDOWNER'S CERTIFICATION: This water well was (1) constructed, (2) reconstructed, or (3) plugged under my jurisdiction and was completed on (mo/day/year) 9-06-94 and this record is true to the best of my knowledge and belief. Kansas Water Well Contractor's License No. 182 This Water Well Record was completed on (mo/day/yr) 10-10-94
under the business name of STRADER DRILLING CO., INC. by (signature) Dale Strader

INSTRUCTIONS: Use typewriter or ball point pen. *PLEASE PRESS FIRMLY* and *PRINT* clearly. Please fill in blanks, underline or circle the correct answers. Send top three copies to Kansas Department of Health and Environment, Bureau of Water, Topeka, Kansas 66620-0001. Telephone: 913-296-5545. Send one to WATER WELL OWNER and retain one for your records.

OFFICE USE ONLY T R E/W SEC. ¼ ¼ ¼