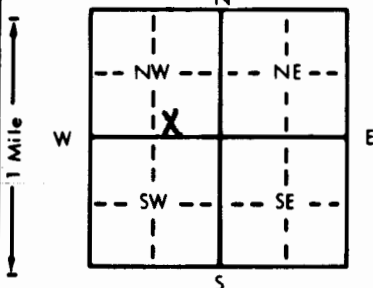


1 LOCATION OF WATER WELL: Fraction SW 1/4 SE 1/4 NW 1/4 Section Number 13 Township Number T 12 S Range Number R 13 E/W  
 County: SHAWNEE

Distance and direction from nearest town or city street address of well if located within city?  
1/2 E 3/4 N of Dovel

2 WATER WELL OWNER: Wittmer REalty  
 RR#, St. Address, Box # : 1136 SW Wanamaker Road Board of Agriculture, Division of Water Resources  
 City, State, ZIP Code : Topeka, KS 66604 Application Number:

3 LOCATE WELL'S LOCATION WITH AN "X" IN SECTION BOX:  


4 DEPTH OF COMPLETED WELL... 120 ft. ELEVATION: .....  
 Depth(s) Groundwater Encountered 1. 30 ft. 2. .... ft. 3. .... ft.  
 WELL'S STATIC WATER LEVEL 25' ft. below land surface measured on mo/day/yr 7-13-88  
 Pump test data: Well water was ..... ft. after ..... hours pumping ..... gpm  
 Est. Yield 1 1/2 gpm: Well water was ..... ft. after ..... hours pumping ..... gpm  
 Bore Hole Diameter... 8. 3/4 in. to ..... ft., and ..... in. to ..... ft.  
 WELL WATER TO BE USED AS: 5 Public water supply 8 Air conditioning 11 Injection well  
1 Domestic 3 Feedlot 6 Oil field water supply 9 Dewatering 12 Other (Specify below)  
2 Irrigation 4 Industrial 7 Lawn and garden only 10 Monitoring well .....  
 Was a chemical/bacteriological sample submitted to Department? Yes.....No.....X...; If yes, mo/day/yr sample was submitted  
 Water Well Disinfected? Yes X No

5 TYPE OF BLANK CASING USED: 5 Wrought iron 8 Concrete tile CASING JOINTS: Glued X Clamped .....  
 1 Steel 3 RMP (SR) 6 Asbestos-Cement 9 Other (specify below) Welded .....  
 2 PVC 4 ABS 7 Fiberglass ..... Threaded.....  
 Blank casing diameter ..... 5"..... in. to ..... 0-25 ..... ft., Dia. .... 5"..... in. to 35-99 ..... ft., Dia. .... 5"..... in. to 100-120 ..... ft.  
 Casing height above land surface..... 24"..... in., weight ..... 2.82 ..... lbs./ft. Wall thickness or gauge No. .... XX .258.....  
 TYPE OF SCREEN OR PERFORATION MATERIAL: 7 PVC 10 Asbestos-cement  
 1 Steel 3 Stainless steel 5 Fiberglass 8 RMP (SR) 11 Other (specify) .....  
 2 Brass 4 Galvanized steel 6 Concrete tile 9 ABS 12 None used (open hole)  
 SCREEN OR PERFORATION OPENINGS ARE: 5 Gauzed wrapped 8 Saw cut 11 None (open hole)  
 1 Continuous slot 3 Mill slot 6 Wire wrapped 9 Drilled holes  
 2 Louvered shutter 4 Key punched 7 Torch cut 10 Other (specify) .....  
 SCREEN-PERFORATED INTERVALS: From 25 ..... ft. to 35 ..... ft., From ..... ft. to ..... ft.  
 From 99 ..... ft. to 100 ..... ft., From ..... ft. to ..... ft.  
 GRAVEL PACK INTERVALS: From 20 ..... ft. to 120 ..... ft., From ..... ft. to ..... ft.  
 From ..... ft. to ..... ft., From ..... ft. to ..... ft.

6 GROUT MATERIAL: 1 Neat cement 2 Cement grout 3 Bentonite 4 Other .....  
 Grout Intervals: From 0 ..... ft. to 20 ..... ft., From ..... ft. to ..... ft., From ..... ft. to ..... ft.  
 What is the nearest source of possible contamination:  
 1 Septic tank 4 Lateral lines 7 Pit privy 10 Livestock pens 14 Abandoned water well  
 2 Sewer lines 5 Cess pool 8 Sewage lagoon 11 Fuel storage 15 Oil well/Gas well  
 3 Watertight sewer lines 6 Seepage pit 9 Feedyard 12 Fertilizer storage 16 Other (specify below)  
 13 Insecticide storage .....  
 Direction from well? S How many feet? 420

FROM	TO	LITHOLOGIC LOG	FROM	TO	PLUGGING INTERVALS
0	1	Top Soil			
1	6	Clay-Brown			
6	8	Limestone-Yellow			
8	18	Shale-Yellow			
18	28	Shale-grey			
28	30	Sandstone-Yellow <u>1 1/2 GPM</u>			
30	63	Shale-Grey			
63	65	Limestone-Grey			
65	73	Shale-grey			
73	90	Limestone-Grey			
90	120	Shale-Grey			

7 CONTRACTOR'S OR LANDOWNER'S CERTIFICATION: This water well was (1) constructed, (2) reconstructed, or (3) plugged under my jurisdiction and was completed on (mo/day/year) 7-13-88 and this record is true to the best of my knowledge and belief. Kansas Water Well Contractor's License No. 182 This Water Well Record was completed on (mo/day/yr) 7-27-88 under the business name of Strader Drilling Co., Inc. by (signature) Dale Skren

INSTRUCTIONS: Use typewriter or ball point pen. PLEASE PRESS FIRMLY and PRINT clearly. Please fill in blanks, underline or circle the correct answers. Send top three copies to Kansas Department of Health and Environment, Bureau of Water Protection, Topeka, Kansas 66620-7320. Telephone: 913-296-5514. Send one to WATER WELL OWNER and retain one for your records.